

Map No. **KANSAS** Sec. 10 Twp. 12^s 9^w R. 9

Well No. 1-Middlecraft Farm
Prairie Company

NORTH

0							

13

WEST

EAST

SOUTH

Location.....

Rig Up.....

Drilling Remarks

Drilling Remarks

.....

.....

RECORD

PRODUCTION

Cased..... in..... ft.

1st 24 hrs. Nat.....

Sand.....

1st 24 hrs. after shot.....

Gas.....

Gas..... cu. ft.....

Oil.....

Dry Hole.....

Total Depth.....

Abandoned.....

Map No. Sec. Twp. R.

Well No. Farm


..... Company

..... Ft. from N. Line

..... Ft. from S. Line

..... Ft. from E. Line

..... Ft. from W. Line

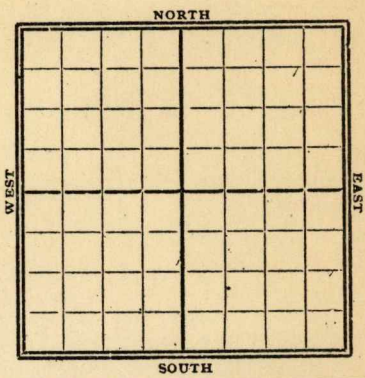

1919

Date

REPORT

Gypsy Records

4/10

Ord TD 3572'

MAP No. _____ SEC. 10 TWP. 17S R. 9W

WELL No. 1 Middlecott

Prairie COMPANY

CONTRACTOR

no well map

SECTION PLAT

0			

_____ FT. FROM N. LINE

_____ FT. FROM S. LINE

_____ FT. FROM E. LINE

_____ FT. FROM W. LINE

LOCATION _____

RIG UP _____

DRILLING AND REMARKS:

RECORD

CASED _____ IN. _____ FT.

SAND _____

GAS _____

OIL _____

TOTAL DEPTH 3572

PRODUCTION

1ST 24 HRS. NAT. _____

1ST 24 HRS. AFTER SHOT _____

GAS _____ CU. FT.

DRY HOLE

ABANDONED

DATE

4-10 1927

SCOUT