

Cowley

KANSAS

12

33S

3E

SECTION _____ TOWNSHIP _____ RANGE _____

WELL NO. #1-W Kroth


COMPANY Crest Petr.

NORTH

C S/2 SW NE

WEST

EAST

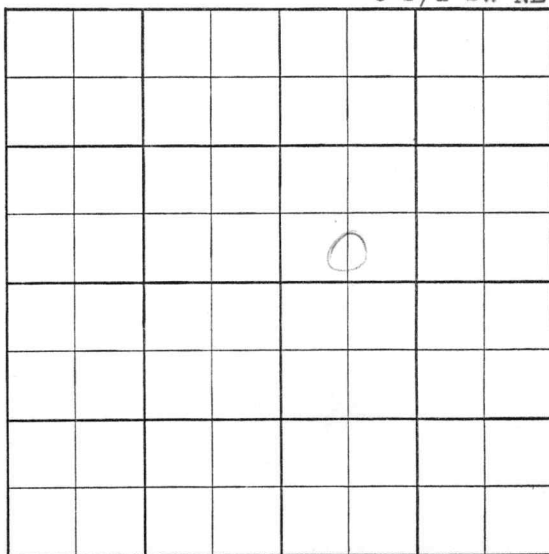

SOUTH

CO. Cowley ELEV. _____

SEC. 12 TWP. 33 RGE. 3E

COMPANY Crest Pet. NO. 1-W

DEC 18 57

FIRST REPORT

FARM _____ Kroth

LOC. C S/2 SW NE SWD

GEOL.

CONTR. Wrico

POOL Confidential

SPUD 12-15-57

8" @ 125 WOC

CO. ~~Cowley~~ ELEV. _____SEC. 12 TWP. 33 RGE. 3ECOMPANY Crest Pet. NO. 1-W

ABANDONED

JAN 22 '58

FARM Kroth SWDWLOC. C S/2 SW NE SWD

GEOL. _____

CONTR. WricoPOOL CententialSPUD 12-15-578" @ 125 WOCDEC 26 '57 5721 2204RTD 2206 5 1/22205

JAN 2 '58

SW DW

JAN 8 '58

JAN 15 '58

JAN 22 '58

CO DD 2246 TD100 BW p 6 input ASW DW

CO

LSE

NO.

SEC.

TWP.

RGE.