


Barton

KANSAS

SECTION 15 TOWNSHIP 17 RANGE 13W

WELL NO. #1 Oltmanns

COMPANY Lee Phillips Oil Co.

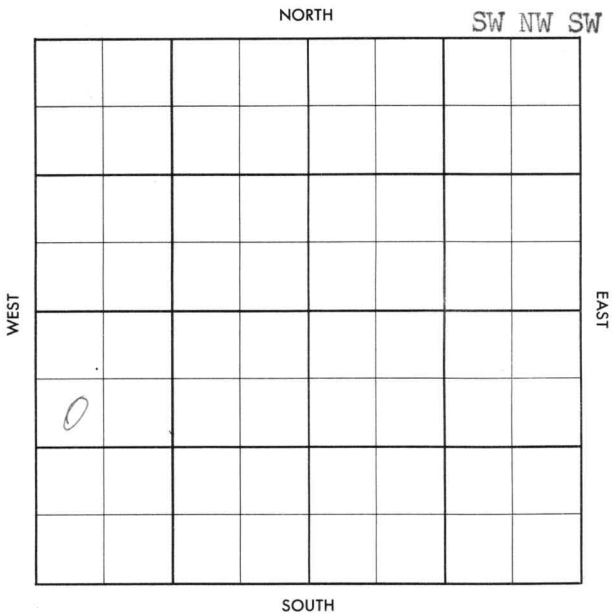

County Barton Elev. _____
 Sec. 15 Twp. 17 Rge. 13W
 Company Lee Phillips Oil Co.
 FarmName Oltmanns No. 1

TOPS	DEPTH	LOG	DATUM
Anh.	855		
TP.			
H.			
Tr.			
Dg.			
Bl.			
L.			
K.C.			
B.K.C.			
Ce.			
C.			
M.			
M.			
K.			
Mz.			
Me.			
V.			
S.			
S.			
A.			
R.			
Pe.			
G.			
T.D.			

Loc. in Sec. SW NW SW
 Geol. S. Powell
 Contr. Harms-Burt
 Pool Hoisington Ex.

FIRST REPORT
 MAY 1 1957

Date Comm. 4-26-57
8" @ 512/275, Drlg. 2060

13

Co.
 Use.
 No.
 Sec.
 T.
 R.

Co.

Loc.

No.

Sec.

T.

R.

County Barton Elev. 1931
 Sec. 15 Twp. 17 Rge. 13W
 Company Lee Phillips Oil Co.
 Farm Name Oltmanns No. 1

TOPS	DEPTH	LOG	DATUM	Loc. in Sec.
Anh.	855			SW NW SW
TP.				
H.	3070			
Tr.				
Dg.				
Bl.	3158	3178		
L.	3171			Geol. S. Powell
K.C.				Contr.
B.K.C.				Harms-Burt
Ce.				Pool
C.				Hoisington Ex.
M.				
M.				
K.				
Mz.				
Me.				
V.				
S.				
S.				
A.	3390			
R.				
PE.				
G.				
TD.	3405			

AUG 22 '57
 COMPLETE

Date Comm. 4-26-57
8" @ 512/275, Drlg. 2060 MAY 8 '57 DST
3290-3300 1hr run 90' SOC
M BHP 1025/20 DST 3390
-3405 1hr run 1440' cl. oil
+60' HOCM ^{13HP} 1330 ^{FBHP} 945/20"
5 1/2 3393/150 MAY 15 '57 WOCT MAY 22 '57
CO 3405 FU 1000' oil 176/w 1hr
TCR MAY 29 '57 POT JUN 5 '57 JUN 12 '57 JUN 19 '57
JUN 26 '57 JUL 3 '57 JUL 10 '57 JUL 17 '57 JUL 24 '57
AUG 8 '57 AUG 14 '57 AUG 21 '57 @ 2580PD to x Arb.