


Section 12 Township 33 Range 3 E

Well No. # 1 Whetson

Company Sunray

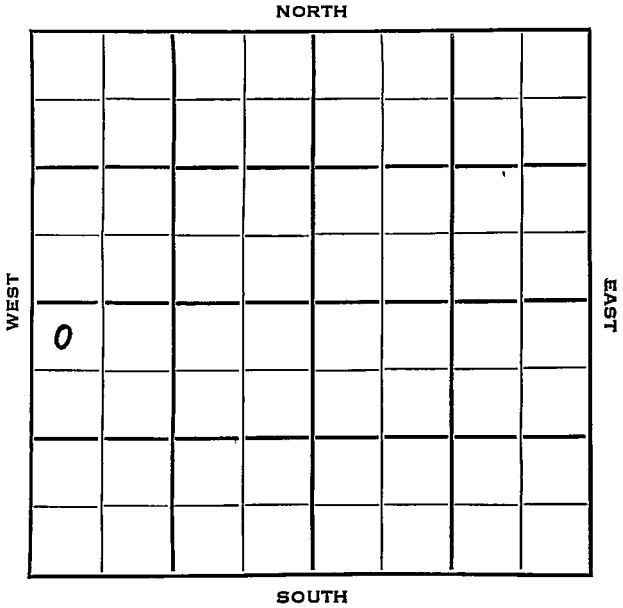

Sec. 12 Twp. 33 R. 3E

Well No. #1 Whetson Farm \_\_\_\_\_

Sunray Company \_\_\_\_\_


Contractor \_\_\_\_\_

330 Ft. from N. Line

\_\_\_\_\_ Ft. from S. Line

\_\_\_\_\_ Ft. from E. Line

330 Ft. from W. Line

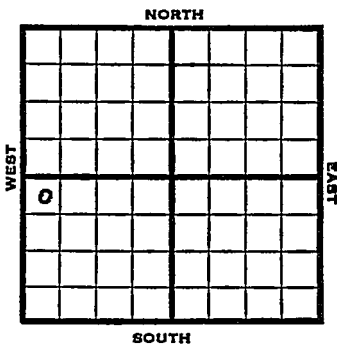

NW NW SW

1953

Elev. 1172'

REPORT

7/22

Location

8/19

Spud 7-26-53

D&A

TD 3283

8" @ 80

Layton 2607, KC 2780, B KC 2896,

Oswego 2967, Bart 3278

TD 3283

5" @ 3279

CO to 3283

1 goph 12hrs.,

Sd-frac

D&A

**ABANDONED**



County Cowley State KansasSec. 12 (Blk. 1 Twp.) 33 (Sur. 3E Rge.) 3E Map No.Operator SunrayWell No. 1 Farm WhitsonElev. 1172 Location NW NW SW

0					
<b>ABANDONED</b>					

330 Ft. From N Line SW330 Ft. From W Line Quarter

1st. Report

Completion AUG 19 1953

Remarks

Spudding Date 7-26-53Drig. Data D & A TD 32838" @ 80 Layton 2607 KC 2780B KC 2896 Oswego 2967 Bart. 3278TD 3283 5" @ 3279 CO to 32831 goph 12 hr. sd-fracD & A