


Cowley KANSAS

SECTION 12 TOWNSHIP 33S RANGE 3E

WELL NO. #2 L. Whitson

COMPANY Crest Petroleum NE NE SE
NORTH SE NW SW

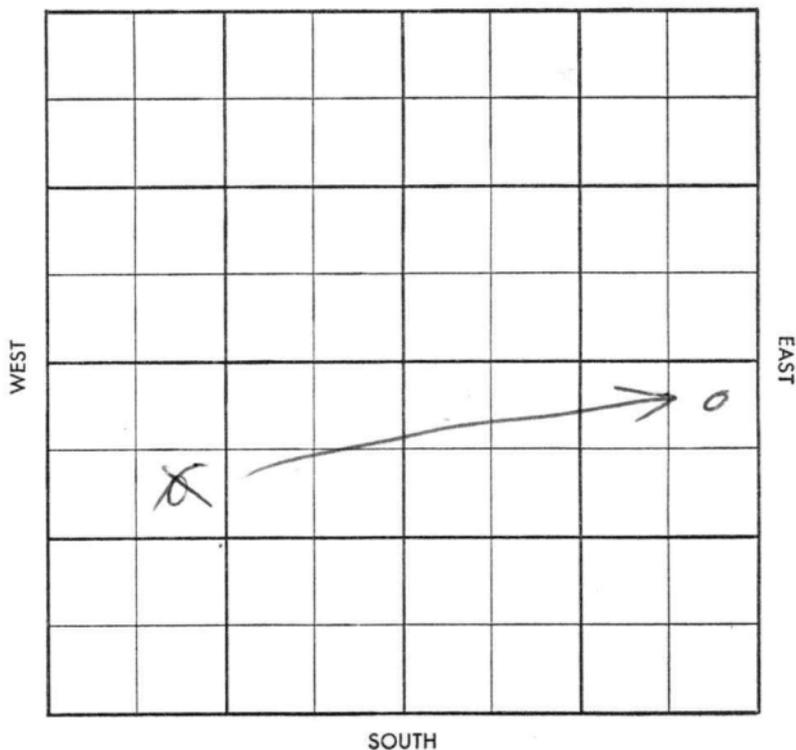

Twp. Pool
CORRECTION
 Facet

8-513-B

County Cowley Elev. 1177
 Sec. 12 Twp. 33 Rge. 3E
 Company Crest Petroleum
 Farm Name L. Whitson No. 2

TOPS	DEPTH	LOG	DATUM
Anth.			
Tp.			
H.			
Tr.			
Dg.			
B.L.			
L.			
K.C.			
B.K.C.			
Ce.			
C.			
M.	<u>3226</u>		
M.			
K.			
Mz.			
Mq.			
V.			
S.			
S.			
A.			
R.			
Pf.			
G.			
T.D.	<u>3233</u>		

Loc. in Sec.
~~SE 1/4~~
~~NE 1/4~~
~~SW 1/4~~
 Geol.
 Contr.
 Co. Tools
 Pool
 Crane

COMPLETE
 SEP 24 1958

Date Comm. 8-1-58 8" 147/100
 WIRT AUG 6 '58 Ø 1720 AUG 13 '58 5 1/2
3229 X AUG 20 '58 AUG 27 '58 CO 3233
SW 1/4 NW 1/4 P4 8hr SF 6x5 Sol
 SEP 3 '58 P 25/B 0 pd SEP 10 '58 SEP 17 '58
 SEP 24 '58 IPP 265 30 PD
Miss

C
 I
 No.
 Sec.
 T.
 R.