


Section 15 Township 33 Range 3E

Well No. #4 Miller

Company Crest Petroleum

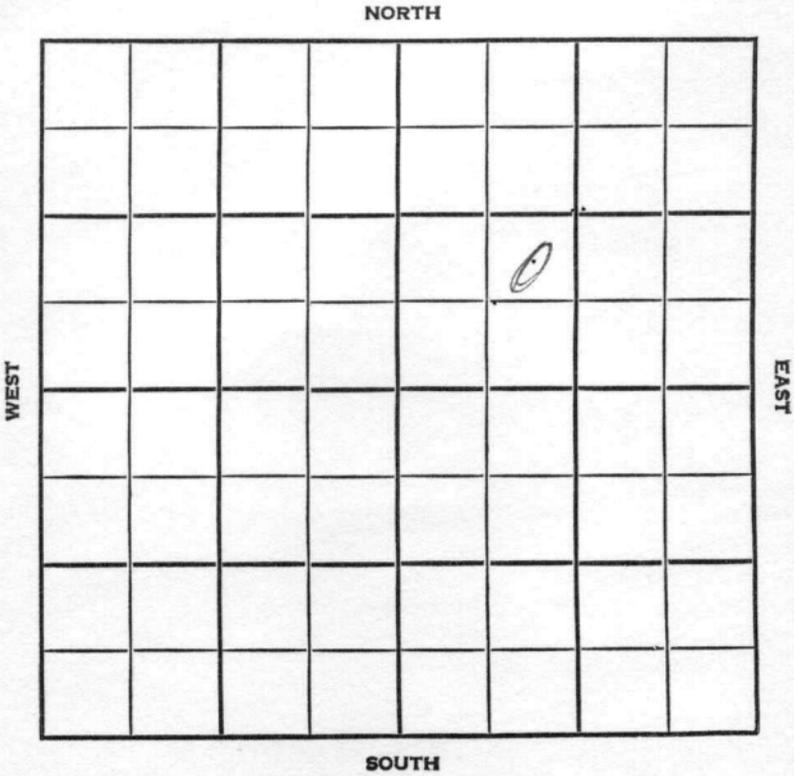

County Cowley Elev. _____
 Sec. 15 Twp. 33 Rgs. 3E
 Company Crest Petroleum
 Farm Name Miller No. 4

TOPS	DEPTH	LOG	DATUM
Anh.			
Tp.			
H.			
Tr.			
Dg.			
Bl.			
L.			
K.C.			
B.K.C.			
Ce.			
C.			
M.			
M.			
K.			
Mz.			
Me.			
V.			
S.			
S.			
A.			
R.			
Pe.			
G.			
T.D.			

Loc. in Sec. NE SW NE
 Geol. _____
 Contr. _____
Wrico Tools
 Pool _____

FIRST REPORT
 0
 OCT 31 1956

Date Comm. _____

Location _____

NOV 5 1956


219

R.G.

Co.
Lse.
No.
Sec.
T.
R.

County Cowley Elev. 1169
 Sec. 15 Twp. 33 Rge. 3E
 Company Crest Petroleum
 Farm Name Miller No. 4

TOPS	DEPTH	LOG	DATUM	Loc. in Sec.
Anh.				NE SW NE
Tp.				
H. <u>5221</u>	<u>2334</u>			
Tr. <u>624</u>	<u>2628</u>			
Dg.				
Bl.				
L.				
K.C.	<u>2790</u>			Geol.
B.H. <u>05W</u>	<u>2980</u>			Contr.
Ce. <u>57</u>	<u>3080</u>			Wrico Tools
C. <u>skinner</u>	<u>3179</u>			
M. <u>chert</u>	<u>3255</u>			Pool
M. <u>61</u>	<u>3278</u>			
K.				
Mz.				
Mo.				
V.				
S.				
S.				
A.				
R.				
PE.				
G.				
T.D.	<u>3298</u>			

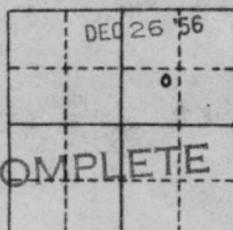

Date Comm. _____
 Location NOV 7 '56 11-#-4-56
858 100/100 NOV 13 '56 2740 NOV 21 '56
5 1/2 3298 NOV 28 '56 CO 3280 47/
3262-70 5 1 Bopd Frac 4 x 4
DEC 5 '56 DEC 12 '56 DEC 19 '56 DEC 26 '56
Ph Pl. 252 Bopd + 2% wt
grav 42°