
Cowley KANSAS

SECTION 15 TOWNSHIP 33 RANGE 3E

WELL NO. #5 Miller

COMPANY Crest Petr. Inc.

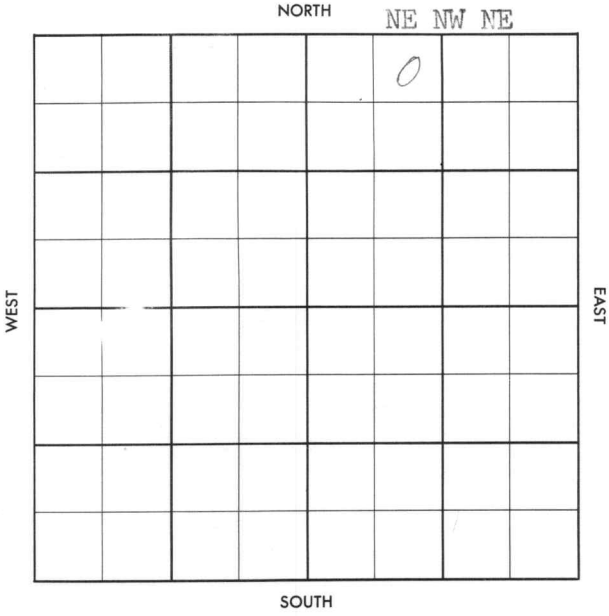

FORM 513 SUNRAY

County Cowley Elev.

Sec. 15 Twp. 33 Rge. 3E

Company Crest Pet. Inc.

Farm Name Miller No. 5

TOPS	DEPTH	LOG	DATUM
Anh.			
Tp.			
H.			
Tr.			
Dg.			
Bl.			
L.			
K.C.			
B.K.C.			
Ce.			
C.			
M.			
M.			
K.			
Mz.			
Mo.			
V.			
S.			
S.			
A			
R.			
Pé.			
G.			
T.D.			

Loc. in Sec. NE NW NE

Geol.

Contr. Wrico Tools

Pool Graham



Date Comm. 3-17-57

8" @ 101/80, Drlg. 478

29

Co. Lse. No. Sec. T. R.

FORM 513 SUNRAY

County Cowley Elev. 1168 DF

Sec. 15 Twp. 33 Rge. 3E

Company Crest Pet. Inc.

Farm Name Miller No. 5

TOPS	DEPTH	LOG	DATUM
Anh. stain	2212		
Tp. Lay	2618		
H.			
Tr.			
Dg.			
Bl.			
L.			
K.C.	2788		
B.K.C. OSW.	2920		
Ce. sh	3086		
C.			
M. chat	3249		
M.			
K.			
Mz.			
Mo.			
V.			
S.			
S.			
A			
R.			
P€.			
G.			
T.D.	3258		

Loc. in Sec. NE NW NE

Geol.

Contr. Wrico Tools

Pool Graham

APR 17 '57

COMPLETE

Date Comm. 3-17-57

8" @ 101/80, Drlg. 478 MAR 27 '57 Rasp'e

APR 3 '57 5½ @ 3252 / APR 10 '57 CO

3258 TD FO 300' oil, no w

12 hrs Frac. Flwd 60 Bbls

2 hrs S.I. APR 17 '57 Ph Flw 371

Bopd + Trace wtr grav 41.7°