Cowley KANSAS

SECTION 15 TOWNSHIP 33 RANGE 3E

WELL NO. #6 Miller

COMPANY Crest Petroleum

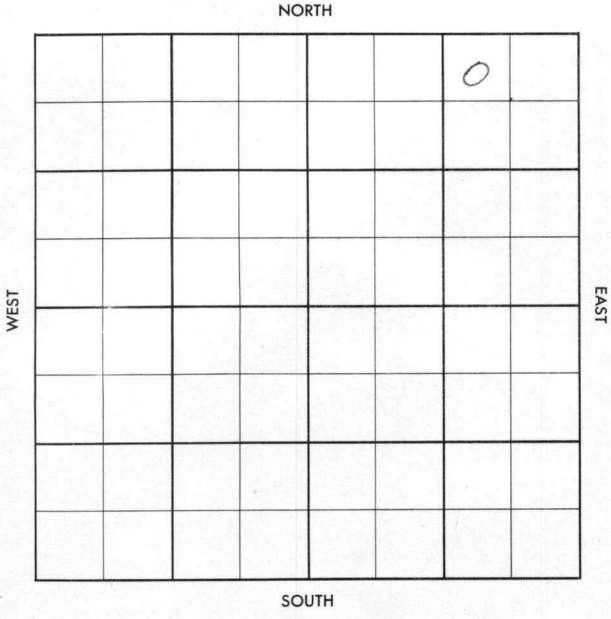

FORM 504-3 SUNRAY

FORM 513 SUNRAY

County Cowley Elev.

Sec. 15 Twp. 33 Rge. 3E

Company Crest Petroleum

Farm Name Miller No. 6

TOPS	DEPTH	LOG	DATUM
Anh.			
Tp.			
H.			
Tr.			
Dg.			
Bl.			
L.			
K.C.			
B.K.C.			
Ce.			
C.			
M.			
M.			
K.			
Mz.			
Mo.			
V.			
S.			
S.			
A			
R.			
P£.			
G.			
T.D.			

Loc. in Sec. NW NE NE

Geol.

Contr. Wm. Co

Pool Graham

FIRST REPORT

JAN 15 '57

Date Comm.

M I R

29

Co. Lse. No. Sec. T. R.

FORM 513 SUNRAY

County Cowley Elev. 1169

Sec. 15 Twp. 33 Rge. 3E

Company Crest Petroleum

FarmName Miller No. 6

TOPS	DEPTH	LOG	DATUM
Anh.			
Tp. Stall sd	2212		
H. Lay sd	2632		
Tr.			
Dg.			
Bl.			
L.			
K.C.	2804		
B.K.C. osw	2986		
Ce. sh	3096		
C.			
M. chert	3272		
M.			
K.			
Mz.			
Mo.			
V.			
S.			
S.			
A			
R.			
P€.			
G.			
T.D.	3284		

Loc. in Sec. NW NE NE

Geol.

Contr. Wrico

Pool Graham

APR 3 '57

COMPLETE

Date Comm.

M T R JAN 23 '57 1-14-57 8 5/8

1001.80 Ø 2670 JAN 30 5½ 3275

FEB 6 '57 ✓ FEB 13 '57 CO 3284 Frac

1/4 Flwd 200 Bo in 7hr

+ Trace wtr S.I FEB 20 '57 wo Pot

FEB 27 '57 MAR 6 '57 MAR 13 '57 MAR 20 '57 MAR 27 '57 APR 3 '57

Ph Flw 341 Bopd + 3% wtr grav 42°

Co. Lse. No. Sec. T. R.