
Cowley KANSAS

SECTION 15 TOWNSHIP 33S RANGE 3E

WELL NO. #8 Miller

COMPANY Crest Petroleum

NORTH SE SW NE

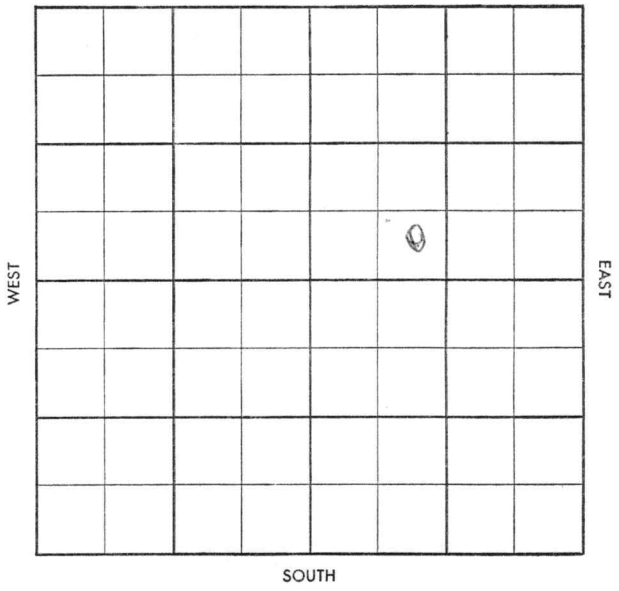

FORM 504-3 SUNRAY

Twp. X Pool

Co. X Feast

S-513-B

County Cowley Elev.

Sec. 15 Twp. 33 Rge. 3 E

Company Crext Petroleum

Farm Name Miller No. 8

TOPS	DEPTH	LOG	DATUM
Anh.			
Tp.			
H.			
Tr.			
Dg.			
B. L.			
L.			
K.C.			
B.K.C.			
Ce.			
C.			
M.			
M.			
K.			
Mz.			
Mq.			
V.			
S.			
S.			
A.			
R.			
Pf.			
G.			
T.D.			

Loc. in Sec.

SE SW NE

Geol.

Contr.

Wrico Tools

Pool

Graham


JL 16 59

FIRST REPORT

Date Comm.

Location

Co. Lse. No. Sec. T. R.

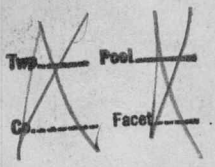

S-513-B

Co.

County Cowley Elev 1167DF 1170RB

Sec. 15 Twp. 33 Rge. 3E

Company Crest Petroleum

Farm Name Miller No. 8

TOPS	DEPTH	LOG	DATUM
Anh. 8 fal	2230		
Tp. Log	2628		
H.			
Tr.			
Dg.			
B. L.			
L.			
K.C.	2796		
B.K.C. 65W	2984		
Ce.	3094		
C.			
M.	3263		
M.			
K.			
Mz.			
Mq.			
V.			
S.			
S.			
A.			
R.			
Pf.			
G.			
T.D.	3270		

Loc. in Sec. SE SW NW

Geol.

Contr. Wrico Tools

Pool Graham

COMPLETE AUG 6 '58 AUG 6 '58

Lse

No.

Date Comm. 7 8"135

Location JUL 28 '58 JUL 30 '58 5" 3265

Sec.

CO 3270 frac F/O L&T F/O

12-15 BOPH NW AUG 6 '58

T.

F/O 25 BOPD NW

R.