


Russell

Form 51-5M-5-34-Palace

Map No. KANSAS Sec. 19 Twp. 12 R. 13W

Well No. #1 Funk Farm _____
Murphy et al Company _____

NORTH

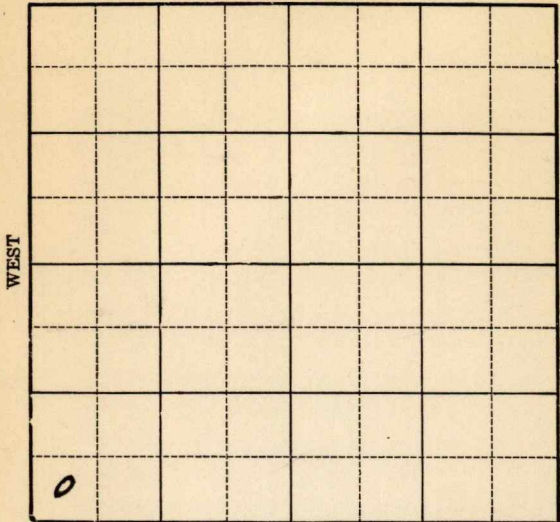

Location _____

Drilling Remarks _____

Rig Up _____

Drilling Remarks _____

RECORD

Cased _____ in. _____ ft.

Sand _____

Gas _____

Oil _____

Total Depth _____

PRODUCTION

1st 24 hrs. Nat. _____

1st 24 hrs. after shot _____

Gas _____ cu. ft.

Dry Hole _____


Abandoned _____

Russell

Map No. KANSAS Sec. 19 Twp. 12 R. 13W

Well No. 1 Funk Farm
Murfin et al Company

_____ Ft. from N. Line
330 Ft. from S. Line
_____ Ft. from E. Line
330 Ft. from W. Line

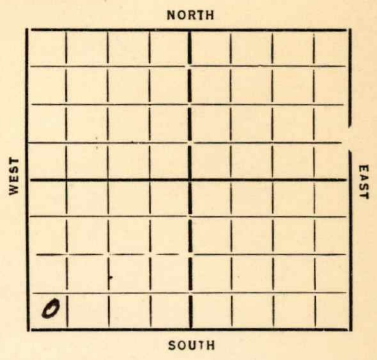

Date 1935 REPORT

1/30 Spud
2/7 _____
2/14 Rgn
2/21 _____ 2/28 _____
3/7 Spud
3/14 20" 218 15" 348 Aubrey 630
12" 695 dly 1320
3/21 dly 2025
3/28 " 2583
4/4 Lansing 2780 8" 2781
fsg 3040
4/10 Siliceous 3213 T 17 3220
170 ft.

ABANDONED

Map No. 72 Sec. 19 Twp. 12 R. 13W

Well No. 1- Trunk

Murfin et al Company

Contractor

FIRST REPORTS SECTION PLAT

..... Ft. from N. Line

330 Ft. from S. Line

..... Ft. from E. Line

330 Ft. from W. Line

0			

Location.....

Rig up.....

Drilling and Remarks:

Spud

RECORD

Cased..... in., ft.

Sand.....

Gas.....

Oil.....

Total Depth.....

PRODUCTION

1st 24 hrs. Nat.....

1st 24 hrs. after shot.....

Gas..... Cu. Ft.

Dry Hole.....

Abandoned.....

Date

1-30-35 192.....

ORVAL MANNSCHECK
Scout

Map No. 72 Sec. 19 Twp. 12 R. 13W
Well No. 1-Opunk

Murphy et al Company

Contractor

ABANDONED

SECTION PLAT

0			

..... Ft. from N. Line

330 Ft. from S. Line

..... Ft. from E. Line

330 Ft. from W. Line

Location.....

Rig up.....

Drilling and Remarks:

NO + A

RECORD

Cased..... in., ft.

Sand Shivers 3213

Gas.....

Oil.....

Total Depth 3220

PRODUCTION

1st 24 hrs. Nat.....

1st 24 hrs. after shot.....

Gas..... Cu. Ft.

Dry Hole.....

Abandoned.....

Date

4-10-35 192.....

ORVAL MANSCHRECK

Scout