

KANSAS


Barton

FORM 51 5M PETROL

Section 12 Township 17 Range 13W

Well No. #1 Underhill

Company Sunray & Margay

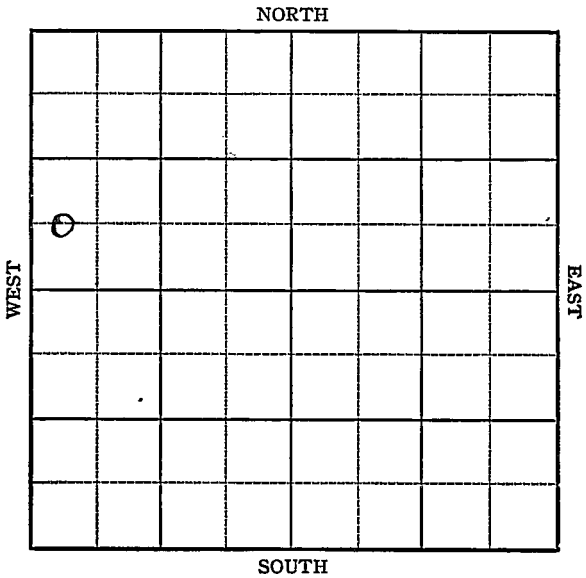

ANSAS

Barton


Sec. 12 Twp. 17 R. 13W

Well No. #1 Underhill Farm

Sunray & Margay Company

Hitchman

NORTH

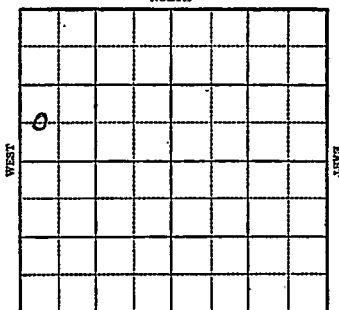

 Ft. from N. Line

660 Ft. from S. Line

 Ft. from E. Line

330 Ft. from W. Line

lev. 1870

1944

R E P O R T

22/16 Rotary

2/23 8" @ 458
Anhy 765
Drlg 1515

3/1 Drlg. 2610'

3/8 Lans 3095
SSO 3125-29
Drlg. 3222

3/16 Lans 3090 corrected
Arb. 3337-42 TD
5" @ 3337
800' oil

3/22 2000' oil

3/29 " "

4/5 5" @ 3337
Arb 3337
TD 3342
Pump 111 oil & 50% water Pot.
Gravity 41.7

COMPLETED

Map No. 73 Sec. 12 Twp. 17 R. 13W

Well No. 1 Underhill

Sunray & Margay Company

FIRST REPORT Contractor

C W L SW NW


SECTION FLAT

 Ft. from N. Line

660 Ft. from S. Line

 Ft. from E. Line

330 Ft. from W. Line

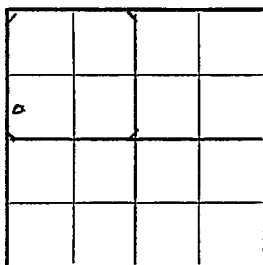

Hitchman Pool

Location

Rig up

Drilling and Remarks:

Rotary

RECORD

Cased in., ft.

Sand

Gas

Oil

Total Depth

PRODUCTION

1st 24 hrs. Nat.

1st 24 hrs. after shot

Gas Cu. Ft.

Dry Hole

Abandoned


Date

FEB 16 1944 19 **S. J. LEWIS** Scout

Map No. 73 Sec. 12 Twp. 17 R. 13WWell No. 1 UnderhillSunray & Margay CompanyCOMPLETED Contractor

C W L SW NW

SECTION PLAT

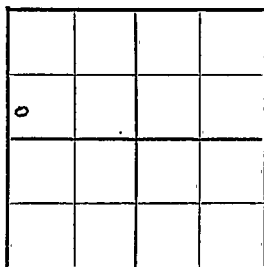

Ft. from N. Line

660

Ft. from S. Line

Ft. from E. Line

330

Ft. from W. Line

Hitchman Pool

Location _____

Rig up _____

Drilling and Remarks:

*Car 3337**5" @ 3337**Pump 111 oil + 58%**Watered 28**41 3/4 in*

RECORD

Cased _____ in., _____ ft.

Sand _____

Gas _____

Oil _____

Total Depth 3342

PRODUCTION

1st 24 hrs. Nat. _____

1st 24 hrs. after shot _____

Gas _____ Cu. Ft.

Dry Hole _____

Abandoned _____

Date

APR 5 1944 19S. J. LEWIS Scout