



**KANSAS**

Russell ✓

Sec. 25 29 Twp. 12 R. 13W

Well No. #1 Wenger Farm \_\_\_\_\_

Brack et al Company \_\_\_\_\_

Wildcat


\_\_\_\_\_ Ft. from N. Line

330' Ft. from S. Line

\_\_\_\_\_ Ft. from E. Line

660' Ft. from W. Line

C S L SW <sup>S</sup> W

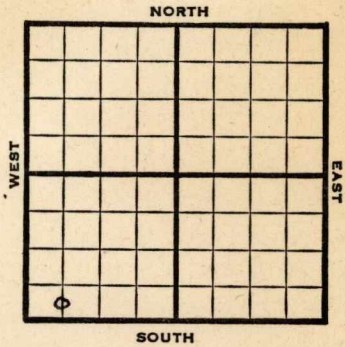

1948

**Elev. 1550'** REPORT

3/3 RUR

3/10 "

3/17 "

3/24 8" @ 114'  
WOC

3/31 **Lansing 2750'**  
**Drlg. 3017'**

4/7 **Viola 3111'**  
**Simp 3172'**  
**Arbuckle 3204'**  
**TD 3257'**

**ABANDONED**

Map No. \_\_\_\_\_ Sec. 25 Twp. 12 R. 13W

Well No. 1 Wenger

Brack etal. Company

FIRST REPORT Contractor

C S L SW SW

SECTION PLAT


\_\_\_\_\_ Ft. from N. Line

330 Ft. from S. Line

\_\_\_\_\_ Ft. from E. Line

660 Ft. from W. Line

Russell County

Location \_\_\_\_\_

Rig up \_\_\_\_\_

Drilling and Remarks:

R U R

RECORD

Cased \_\_\_\_\_ in., \_\_\_\_\_ ft.

Sand \_\_\_\_\_

Gas \_\_\_\_\_

Oil \_\_\_\_\_

Total Depth \_\_\_\_\_

PRODUCTION

1st 24 hrs. Nat. \_\_\_\_\_

1st 24 hrs. after shot \_\_\_\_\_

Gas \_\_\_\_\_ Cu. Ft.

Dry Hole \_\_\_\_\_

Abandoned \_\_\_\_\_

Date

MAR 3 1948

19

S. J. LEWIS Scout

Map No. 22 Sec. 29 Twp. 12 R. 13W

Well No. 1 Wenger

Brack etal. Company

**CORRECTION** Contractor

C S L SW SW

SECTION PLAT


\_\_\_\_\_ Ft. from N. Line

330 Ft. from S. Line

\_\_\_\_\_ Ft. from E. Line

660 Ft. from W. Line

Russell County

RECORD

Location \_\_\_\_\_

Cased \_\_\_\_\_ in., \_\_\_\_\_ ft.

Rig up \_\_\_\_\_

Sand \_\_\_\_\_

Drilling and Remarks:

Gas \_\_\_\_\_

Oil \_\_\_\_\_

Total Depth \_\_\_\_\_

Reported

25-12-13W

PRODUCTION

1st 24 hrs. Nat. \_\_\_\_\_

1st 24 hrs. after shot \_\_\_\_\_

Gas \_\_\_\_\_ Cu. Ft.

Dry Hole \_\_\_\_\_

Abandoned \_\_\_\_\_

Date

MAR 31 1948 19

S. J. LEWIS Scout

Map No. 72 Sec. 29 Twp. 12 R. 13W

Well No. 1 Wenger

Brack et al. Company

ABANDONED Contractor

C S L SW SW

E. 1550  
SECTION PLAT

         Ft. from N. Line

330 Ft. from S. Line

         Ft. from E. Line

660 Ft. from W. Line


Russell County

Location                                 

Rig up                                 

Drilling and Remarks:

*Vista 3111*  
*Swing 3172*  
*Cr 83204*

RECORD

Cased          in.,          ft.

Sand                                 

Gas                                 

Oil                                 

Total Depth 3207

PRODUCTION

1st 24 hrs. Nat.                         

1st 24 hrs. after shot                         

Gas                          Cu. Ft.

Dry Hole                         

Abandoned                         

Date

APR 7 1948 19

S. J. LEWIS

Scout