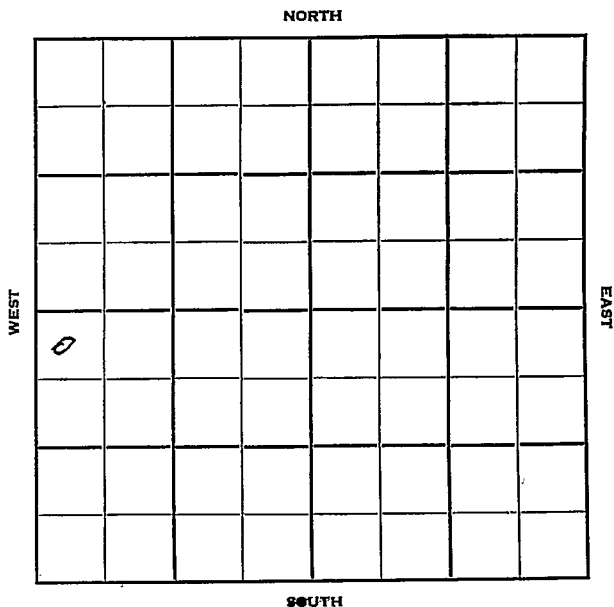


Section 14 Township 17 Range 13WWell No. #1 Underwood "B"Company Darby -Bothwell

KANSAS

Barton

Sec. 14 Twp. 17 R. 13W ✓

Well No. #1 Underwood "B" Farm

Darby - Bothwell Company

Iron Drlg. - Contr. Contractor

Semi-Wildcat


330' Ft. from N. Line

\_\_\_\_\_ Ft. from S. Line

\_\_\_\_\_ Ft. from E. Line

330' Ft. from W. Line

NW NW SW

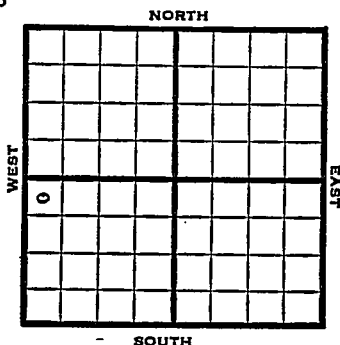

1950

Elev. 1845' REPORT

12/6

Location

12/27

Spud 12-11-50

D&A

TD 3365

8" @ 236'

Anhy 780-815

Heeb. 3010 Dol 3029

Br Lime 3098

Lans. 3112


DST 3240-52 opn 25 min

Rec. 75' mud

Arb. 3349-65 TD

D&A

**ABANDONED**

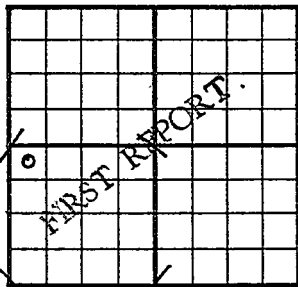County Barton State KansasSec. 14 (Blk.) 17 (Sur.) 13W Map No.Operator Darby - BothwellWell No. 1 Farm Underwood "B"Elev. Location NW NW SW330 Ft. From N Line SW330 Ft. From W Line Quarter1st. Report DEC 6 1950

Completion


Remarks

Iron Drile. - Contr.

Spudding Date

Drig. Data Semi WildcatLocation

J. E. TYRA

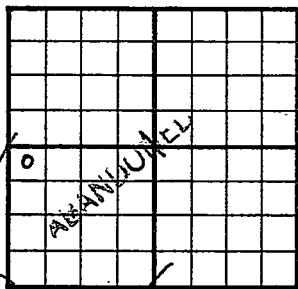County Barton State KansasSec. 14 (Blk.  
Twps.) 17 (Sur.  
Rge.) 13W Map No.Operator Darby - BothwellWell No. 1 Farm Underwood "B"Elev. 1845 Location NW NW SW330 Ft. From N Line SW330 Ft. From W Line Quarter1st. ReportCompletion DEC 27 1950Remarks Semi WildcatIron Drlg. - Contr.Spudding Date 12-11-50Drlg. Data D & A TD 33658" C 236 Anhy 780-815 Heeb. 3010Dol. 3029 Br. lime 3098 Lans. 3112DST 3240-52 open 25 min. Rec. 75' mudArb. 3349-65 TD D & A

J. E. TYRA