

KANSAS

Russell

Section 7 Township 12 Range 14-W

Well No. #1 Roda

Company Sohio & Appleman
Wildcat

NORTH

							0

SOUTH

WEST

EAST

8

Russell
12

KANSAS

Sec. 7 Twp. 12 R. 14W ✓

Well No. #1 Roda Farm

Sohio & Appleman Company

Duke & Woods Contractor

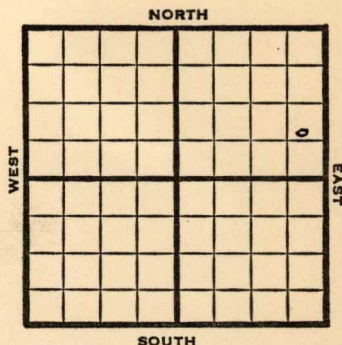
1800' Ft. from N. Line

Ft. from S. Line

330' Ft. from E. Line

Ft. from W. Line

C E L SE NE



1950 Elev. 1755' REPORT

3/8 Spud 3-3-50
8" @ 147'

Anhy 819'

Drlg. 1610'

3/22 8"@ 147'

Anhy 819'

Topeka 2621'

Lans 2927'

DST 2944-85'

Rec 10' oil cut mud

50 mud & salt wtr.

DST 3008-22

Rec 34' mud & salt wtr.

Arb. 3259-80

TD 3280'

D&A

Aband.

ABANDONED

Kansas

Wildcat

Map No. _____ Sec. 7 Twp. 12 R. 14WWell No. 1 Roda_____
Sohio & Appleman Company_____
Duke & Woods Contractor

C E L S E N E

El. 1755

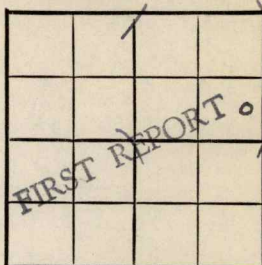
SECTION PLAT

1800 Ft. from N. Line

_____ Ft. from S. Line

330 Ft. from E. Line

_____ Ft. from W. Line

Russell County

Location _____

Rig up _____

Drilling and Remarks: _____

Spud 3-3-50

8" @ 147

Anhy 819

drlg. 1610

RECORD

Cased _____ in., _____ ft.

Sand _____

Gas _____

Oil _____

Total Depth _____

PRODUCTION

1st 24 hrs. Nat. _____

1st 24 hrs. after shot _____

Gas _____ Cu. Ft.

Dry Hole _____

Abandoned _____

Date

MAR 8 1950 19J. E. TYRA Scout

Map No. _____ Sec. 7 Twp. 12 R. 14WWell No. 1 Roda

Sohio & Appleman

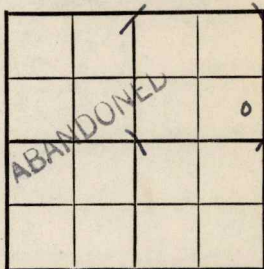
Company

Contractor

C E L S E N E

E. 1755

SECTION PLAT

1800 Ft. from N. Line

Ft. from S. Line

330 Ft. from E. Line

Ft. from W. Line

Russell County

Location _____

Rig up _____

Drilling and Remarks:

8" @ 147
 anhy 819
 2 1/2" 2621
 2 1/2" 2927
 DST 2944-85
 Rec. 10' oil cut mud
 50 mud + salt water
 DST 3008-22
 Rec. 34' mud + salt water
 arb. 3259-80 T.D.
 Date D + A

RECORD

Cased _____ in., _____ ft.

Sand _____

Gas _____

Oil _____

Total Depth _____

PRODUCTION

1st 24 hrs. Nat. _____

1st 24 hrs. after shot _____

Gas _____ Cu. Ft.

Dry Hole _____

Abandoned 3280

MAR 22 1950 19

J. E. TYRA

Scout