


Russell

KANSAS

SECTION 19 TOWNSHIP 12S RANGE 14W

WELL NO. #1 Smith

COMPANY Solar Oil

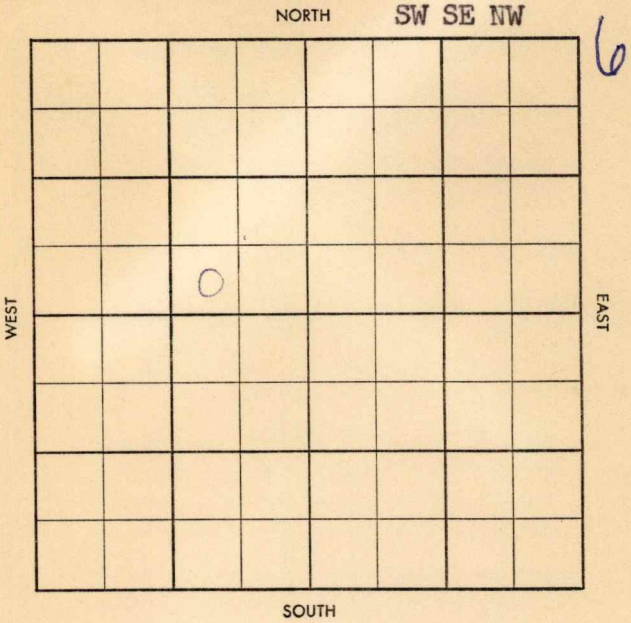

Twp. ~~12~~ Pool ~~14W~~
 Co. ~~19~~ Foot ~~1~~

WILDCAT

S-513-B

County Russell Elev. _____
 Sec. 19 Twp. 12 Rge. 14W
 Company Solar Oil
 Farm Name Smith No. 1

TOPS	DEPTH	LOG	DATUM
Anh.			
Tp.			
H.			
Tr.			
Dg.			
B.L.			
L.			
K.C.			
B.K.C.			
Ce.			
C.			
M.			
M.			
K.			
Mz.			
Mq.			
V.			
S.			
S.			
A.			
R.			
Pf.			
G.			
T.D.			

Loc. in Sec. SW SE NW

Geol. _____
 Contr. Lewis Drlg.

Pool Wildcat

FIRST REPORT
 JUN 25 '58

Date Comm. 6-23-58
drlg. 30

Co.
Lse.
No.
Sec.
T.
R.

Twp. ~~12~~ Pool ~~1~~
 Co. ~~11W~~ Facet ~~1~~

5-513-B

County Russell Elev. 17920 or 180380
 Sec. 19 Twp. 12 Rge. 11W
 Company Solar Oil
 Farm Name Smith No. 1

TOPS	DEPTH	LOG	DATUM	Loc. in Sec.
Anh.				SW SE NW
Tp.				
H.	2928			
Tr.				
Dg.				
B.L.				
L.	2980			
K.C.				Geol.
B.K.C.				Contr.
Ce.				Lewis Drlg.
C.				
M.				Pool
M.				Wildcat
K.				
Mz.				
Mq.				
V.				
S.				ABANDONED
S.				
A.	3284			
R.				
Pf.				
G.				
T.D.	3299			JUL 9 '58

Date Comm. 6-23-58 8" 875/400
 drlg. 30 JUL 2 '58 DST 3009-28 up 30"
15' M spt oil FP 35-0 BHP 0 1/2
DST 3061-80 up 25" 20' DM BHP 795
3090 JUL 9 '58 DST 3138-62 up 30"
12' M BHP 0 1/2" DST 3165-95 up 30"
7' 0 spt M BHP 0 1/2" no log

D&A