


Section 15 Township 33 Range 3E

Well No. #2 Smith

Company W. L. Hartman

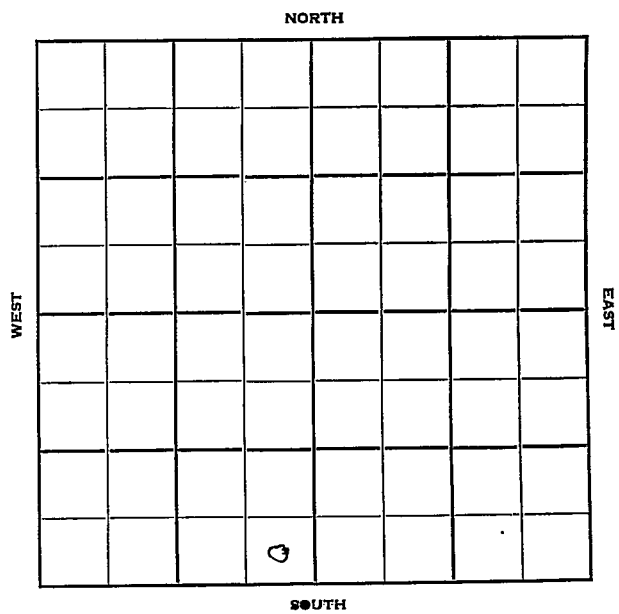

Cowley KANSAS

Sec. 15 Twp. 33 R. 3 E

Well No. # 2 Smith Farm

W. L. Hartman Company

Contractor


 Ft. from N. Line

330 Ft. from S. Line

330 Ft. from E. Line

 Ft. from W. Line

SE SE SW

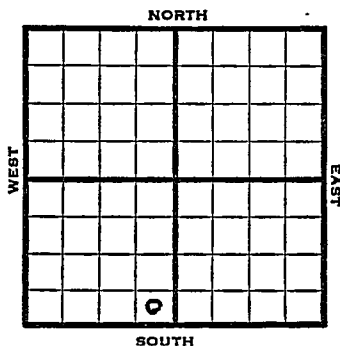

1952

Elev. 1161' REPORT

8/6

Cellar & Pits

9/24

Spud 8-5-52 Oil Well TD 3312

8" 2177 Stal 2199

Layton 2618 KC 2783


Oswego 2971 Bart 3233

Miss 3272 TD 3312

5" @ 3312 PB 3270

Comp. 15 bopd

COMPLETED

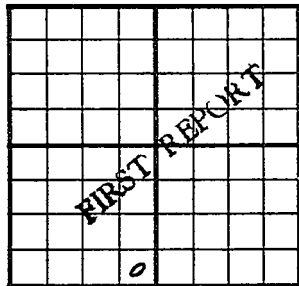County **Cowley** State **Kansas**Sec. **15** (Blk. Twp.) **33** (Sur. Rge.) **3E** Map No.Operator **W. L. Hartman**Well No. **2** Farm **Smith**Elev. Location **SE SE SW****330** Ft. From **S** Line **SW****330** Ft. From **E** Line Quarter1st. Report **AUG 8 1952**

Completion

Remarks

Spudding Date

Drlg. Data

Cellar & pits**J. G. McGEHEE**

Operator W. L. Hartman

Well No. 2 Farm Smith

Elev. 1161 Location SE SE SW

0

COMPLETE

330 Ft. From S Line SW

330 Ft. From E Line Quarter

1st. Report

Completion SEP 24 1952

Remarks

Spudding Date 8-5-52

Drig. Data Oil well TD 3312

8" @ 177 Stal. 2199 Layton 2618

KC 2783 Oswego 2971 Bart. 3233

Miss. 3272 TD 3312 5" @ 3312.

PB 3270 Comp. 15 bopd

J. G. McGEHEE