


Section 15 Township 33 Range 3E

Well No. 1 Smith

Company W. L. Hartman & B. B. Blair

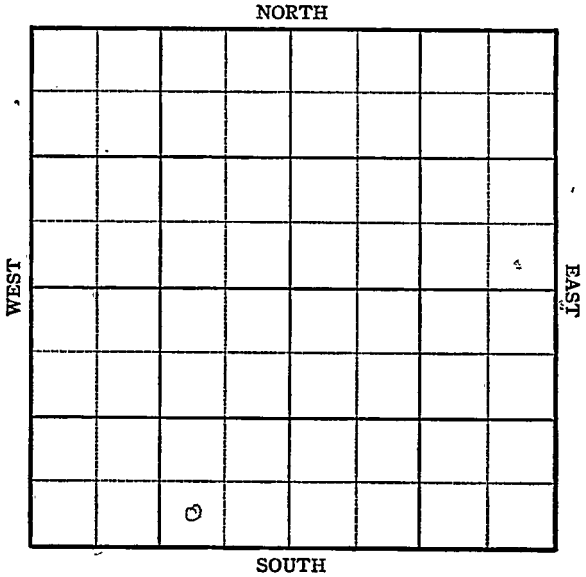

Sec. 15 Twp. 33 R. 3-E

Well No. #1 Smith Farm


W. L. Hartman & B.B. Blair Company

_____ Ft. from N. Line

330 Ft. from S. Line

990 Ft. from E. Line

_____ Ft. from W. Line

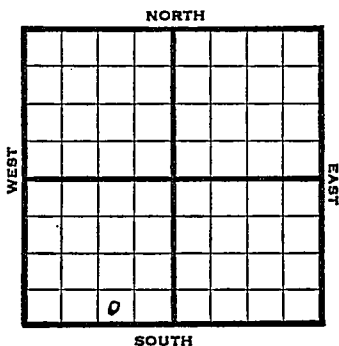

SW SE SW

1945 **Elev. 1150** **REPORT**

- 11/7 Location
- 11/14 10" @ 150
Drlg. 205'
- 11/21 Drlg. 2430
- 11/28 KC 2798
Drlg. 3240
- 12/5 " " "
- 12/12 Miss. 3259
TD 3266
5" @ 3247 RUST
- 12/20 Fsg.
- 12/29 Est 75 oil
- 1946
- 1/10 " "
- 1/17 " "
- 1/24 " "
- 1/30 Bart. 3223
Miss. 3259
5" @ 3247
TD 3266
Pump 75 Pot.
Grav. 36.0

COMPLETED

KANSAS

Kansas

Pool Name MiscellaneousMap No. _____ Sec. 15 Twp. 33 R. 3EWell No. 1 SmithW. L. Hartman & B B Blair Company-1RST REPORT Contractor


SW SE SW

SECTION PLAT

_____ Ft. from N. Line

330 Ft. from S. Line

_____ Ft. from E. Line

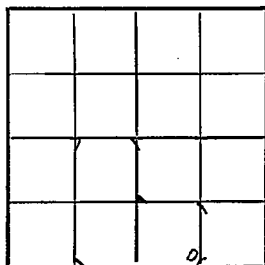990 Ft. from W. Line

Cowley County

Location X

Rig up _____

Drilling and Remarks:

RECORD

Cased _____ in., _____ ft.

Sand _____

Gas _____

Oil _____

Total Depth _____

PRODUCTION

1st 24 hrs. Nat. _____

1st 24 hrs. after shot _____

Gas _____ Cu. Ft.

Dry Hole _____

Abandoned _____

Date

NOV 7 1945 19S. J. LEWIS Scout

check spot and
feet measurements
Advise
Sam

Misc. Small Maps	OK
Cards	
Tracing	OK
France Map	OK
Scarborough Map	OK
Pierce Map	OK
Geological Dept.	✓
Pierce Plat Book	

KANSAS

Kansas Pool Name Miscellaneous

Map No. 7 Sec. 15 Twp. 33 R. 3E

Well No. 1 Smith

W. L. Hartman & B B Blair Company

COMPLETED

Contractor

SW SE SW

E 1, 158
SECTION PLAT

_____ Ft. from N. Line

330 Ft. from S. Line

990 Ft. from E. Line

_____ Ft. from W. Line

Cowley County

Location _____

Rig up _____

Drilling and Remarks:

Bar 10225
Miss 8257
5" 03247
Pump 75 Bd

26 2 gr

RECORD

Cased _____ in., _____ ft.

Sand _____

Gas _____

Oil _____

Total Depth 8266

PRODUCTION

1st 24 hrs. Nat. _____

1st 24 hrs. after shot _____

Gas _____ Cu. Ft.

Dry Hole _____

Abandoned _____

Date

JAN 3 0 1946

19

S. J. LEWIS

Scout