


Section 15 Township 30 Range 1E

Well No. #6 Cox

Company Sunray

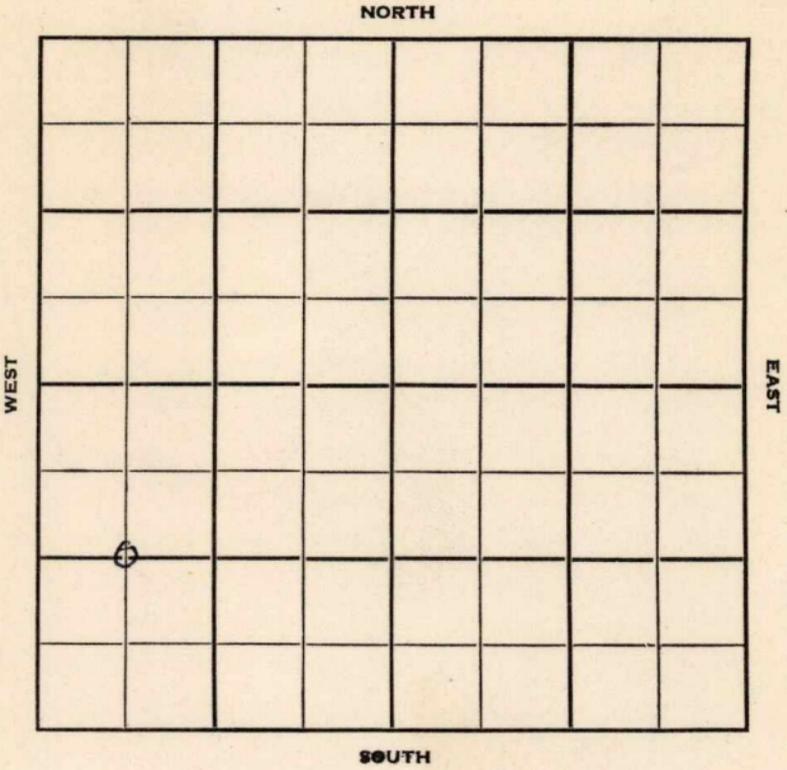

Summer

KANSAS

Sec. 15 Twp. 30 R. 1E

Well No. #6 Cox Farm

Sunray Company

Barnett Drlg. - Contr. Contractor

Belman Pool


Ft. from N. Line

1320' Ft. from S. Line

Ft. from E. Line

660' Ft. from W. Line

C W/2 SW

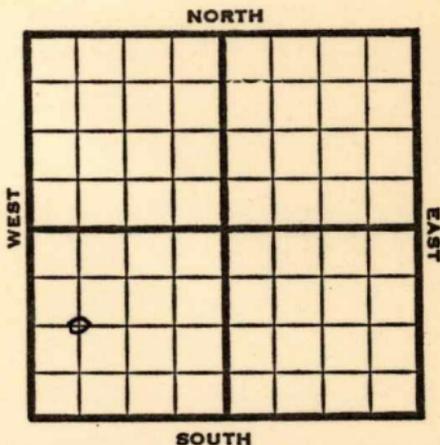

1951 **Elev. 1235'** REPORT

4/25 Spud 4-20-51
8" @ 185

6/13 Drlg. 1650'
Spud 4-20-51
Oil Well TD 3802
8" @ 185

Lans. 2745 Miss 3345
Simp 3795 TD 3798
5" @ 3796 TD 3802
2½ goph Hydrafrac 5 boph
Comp. 55 bopd

COMPLETED

County Sumner State Kansas

Sec. 15 (Blk. Twp.) 30 (Sur. Rge.) 1E Map No.

Operator Sunray

Well No. 6 Farm Cox

Elev. Location C W 1/2 SW



1320 Ft. From S Line SW

660 Ft. From W Line Quarter

1st. Report APR 25 1951

Completion


Remarks

Barnett Drlg. - Contr.

Spudding Date 4-20-51

Drlg. Data Belman Pool

8" @ 185 drlg. 1650

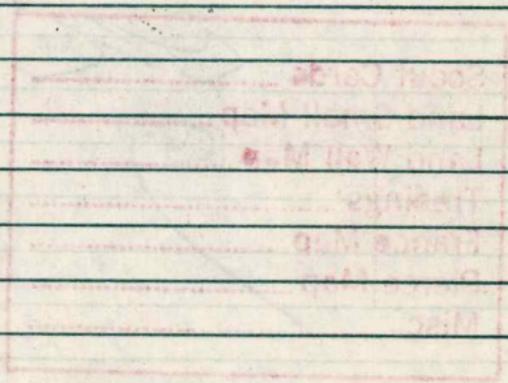

J. E. TYRA

County Sumner State Kansas

Sec. 15 (^{Bik.}_{Twp.}) 30 (^{Sur.}_{Rge.}) 1E Map No.

Operator Sunray

Well No. 6 Farm Cox

Elev. 1235 Location C W $\frac{1}{2}$ SW

COMPLETE

1320 Ft. From S Line SW

660 Ft. From W Line Quarter

Ist. Report

Completion JUN 13 1951

Remarks Belman Pool

Barnett Drlg. - Contr.

Spudding Date 4-20-51

Drlg. Data Oil well TD 3802

8" @ 185 Lans. 2745 Miss. 3345

Simp. 3795 TD 3798 5" @ 3796

TD 3802 2 $\frac{1}{2}$ goph Hydrofrac

5 boph Comp. 55 bopd

J. E. TYRA