


Cowley

KANSAS

SECTION 15 TOWNSHIP 33S RANGE 3E

WELL NO. #3 Smith "A"

COMPANY W.L. Hartman

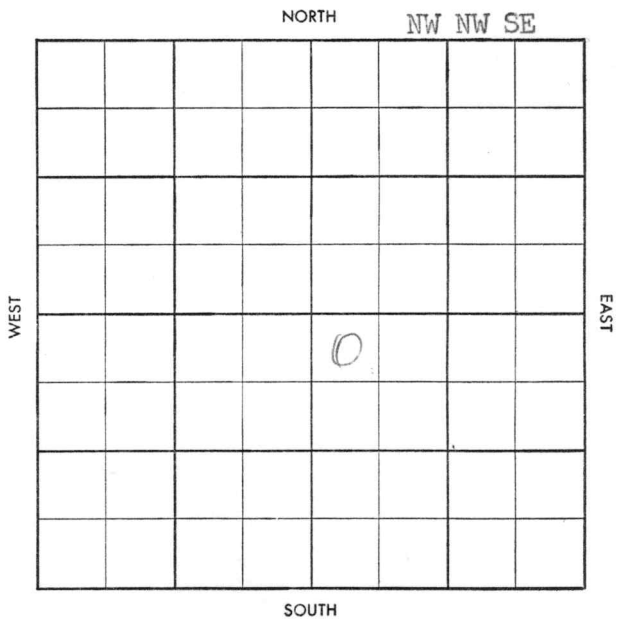

Twp. N Foot. N

Co. X Facet

S-513-B

County Cowley Elev. _____
 Sec. 15 Twp. 33S Rge. 3E
 Company W. L. Hartman
 Farm Name Smith "A" No. 3

TOPS	DEPTH	LOG	DATUM
Anh.			
Tp.			
H.			
Tr.			
Dg.			
B.L.			
L.			
K.C.			
B.K.C.			
Ce.			
C.			
M.			
M.			
K.			
Mz.			
Mq.			
V.			
S.			
S.			
A.			
R.			
Pf.			
G.			
T.D.			

Loc. in Sec. NW NW SE

Geol. _____
Contr. Wrico Tools

Pool Graham



Date Comm. _____
MIRT

Co.

R.

Twp. X Pool X
 Co. X Facet X

S-513-B

County Cowley Elev. 11500 = 11638
 Sec. 15 Twp. 33S Rge. 3E
 Company W. L. Hartman
 Farm Name Smith "A" No. 3

TOPS	DEPTH	LOG	DATUM	Loc. in Sec.
Anh. <u>S 1 1/2</u>	<u>2209</u>			NW NW SE
Tp. <u>2 1/2</u>	<u>2620</u>			
H. <u>BW 1 2</u>	<u>3227</u>			
Tr.				
Dg.				
B.L.				
L.				
K.C.				Geol.
B.K.C.				Contr.
Ce.				<u>Wrico Tools</u>
C.				
M.	<u>32545</u>			Pool
M. <u>Lm</u>	<u>3280</u>			<u>Graham</u>
K.				
Mz.				
Mq.				
V.				
S.				
S.				
A.				
R.				
Pf.				
G.				
T.D.	<u>3288</u>			

COMPLETE
 0
 MAY 28 '58

Date Conn. 4-12-58
 MIRT MAR 21 58 APR 2 58 APR 9 58 APR 15 58 8" 125
SD APR 23 58 3270 APR 30 58
5" 3288 MAY 7 58 MAY 14 58 MAY 21 58 MAY 28 58
24/ 3246-52 frac

P 25 B 0 d NW
BW 1