

Cowley

DX 78-1

KANSAS

Section 15 Township 33 Range 3E

Well No. #1 Smith "B"

Company W.L. Hartman

NORTH

WEST

EAST

				0			

~~DATA~~

SOUTH

0

Cowley KANSAS

SEC.	TWP.	R.
15	33	3E

WELL NO. **1 Smith "B"** FARM

COMPANY **W. L. Hartman**

CONTRACTOR **Co. Tools**


Rainbow Bend BPool

_____ Ft. from N. Line

990 _____ Ft. from S. Line

_____ Ft. from E. Line

330 _____ Ft. from W. Line

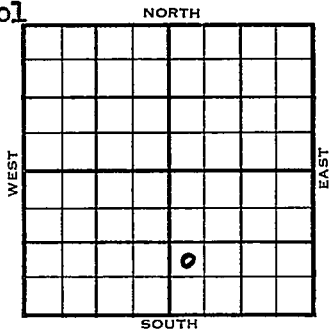

NW SW SE

	ELEVATION	REPORT
1954	1163'	

12/1

MIR

1955

1/12

Oil well TD 3330' 8-5/8" @ 94
 Hoover 1759 Stal. 2215 Layton 2624
 KC 2796 Oswego 2986 Jatan 2177
 Bart. 3255 Miss. chert 3280
 Miss. lime 3312 TD 3330' 5" @ 3330
 CO to 3325 95/3284-3300 FU 250'
 oil 700' wtr. 16 hr.
 Comp. 25 BOPD

COMPLETED

County **Cowley** State **Kansas**

Sec. **15** (Blk: Twp.) **33** (Sur. Rge.) **3E** Map No.

Operator **W. L. Hartman**

Well No. **1** Farm **Smith "B"**

Elev. Location **NW SW SE**

990 Ft. From **S** Line **SE**

330 Ft. From **W** Line Quarter

Ist. Report **DEC 1 1954**

Completion

Remarks

Co. tools

Spudding Date

Drlg. Data **Rainbow Bend Pool**

M I R

FABEN GILSTRAW


County Cowley State Kansas

Sec. 15 (Blk. 33 (Sur. 3E (Twp. 3E Map No.

Operator W. L. Hartman

Well No. 1 Farm Smith "B"

Elev. 1163 Location NW SW SE

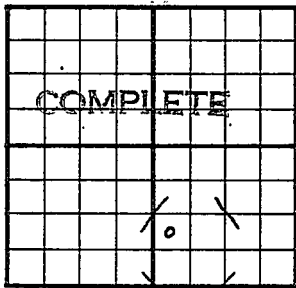

990 Ft. From S Line SE

330 Ft. From W Line Quarter

1st. Report

Completion JAN 1 2 1955

Remarks Rainbow Bend Pool

Co. tools

Spudding Date

Drlg. Data Oil well TD 3330

8 5/8" @ 94 Hoover 1759 Stal. 2215

Layton 2624 KC 2796 Oswego 2986

Jatan 2177 Bart. 3255 Miss. chert 3280

Miss. lime 3312 TD 3330 5" @ 3330

CO to 3325 95/ 3284-3300 FU 250' oil

700' str. 16 hr. Comp. 25 bopd

FABEN GILSTRAP