

Cowley


KANSAS

SECTION 15 TOWNSHIP 33 RANGE 3E

WELL NO. #1 Watts

COMPANY Wrico Drlg.

NORTH

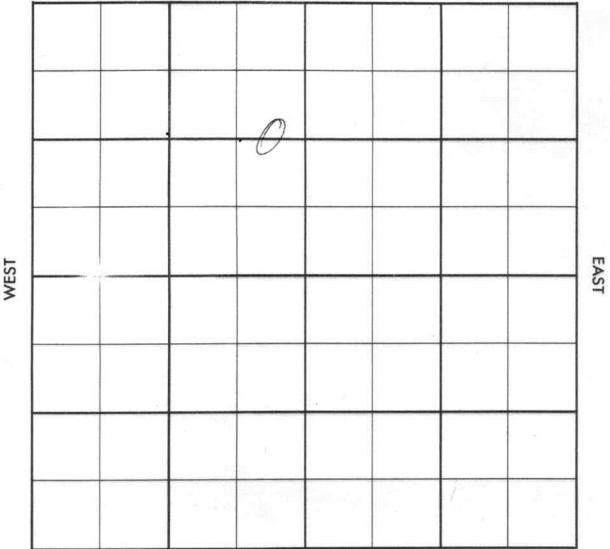

SOUTH

County Cowley Elev. _____
 Sec. 15 Twp. 33 Rge. 3E
 Company Wrico Drlg.
 Farm Name Watts No. 1

TOPS	DEPTH	LOG	DATUM	Loc. in Sec.
Anh.				<u>C E/2 E/2 NW</u>
Tp.				
H.				
Tr.				
Dg.				
Bl.				
L.				Geol. _____
K.C.				Contr. _____
B.K.C.				Co. Tools _____
Ce.				Pool _____
C.				Graham _____
M.				FIRST REPORT DEC 19 55
M.				
K.				
Mz.				
Me.				
V.				
S.				
S.				
A.				
R.				
Pe.				
G.				
T.D.				

Date Comm.

MIRT29

County Cowley Elev. 1163 Co. 1
 Sec. 15 Twp. 33 Rge. 3E
 Company Arco Drlg.
 Farm Name Watts No. 1

TOPS	DEPTH	LOG	DATUM	Loc. in Sec.
Anb.				C E/2 E/2 NW
Tp.				
H. <u>5211</u>	<u>2208</u>			
Tr. <u>624</u>	<u>2615</u>			
Dg.				
BL.				
L.				
K.C.	<u>2777</u>			Geol.
B.K.C.				Contr.
Gr. <u>05W</u>	<u>2959</u>			Co. Tools
C.				Pool
M. <u>Bart/5d</u>	<u>3222</u>			Graham
M. <u>chat</u>	<u>3248</u>			
K. <u>M. L1</u>	<u>3256</u>			
Mz.				
Ma.				
V.				
S.				
S.				
A.				
R.				
Pe.				
G.				
T.D. <u>3269</u>	<u>3256</u>			



Date Comm.

MIRT - DEC 26 '55 12-22-56 8 1/8

101 S.O 2400 JAN 2 '57 5 1/2 @

3255 JAN 9 '57 5 1/2 3269 CO

JAN 18 '57 CO 3263 16/3245-49

Hole Full wth ~~16 1/2~~ 1 1/4 S.O.

DOCK SQ FRAC 4 X 4 JAN 23 '57

Lost Load PB 23 3241 32/

3226-34 FRAC 1 6 Bot 2

Bwph 8 hne T&R JAN 30 '57 FEB 6 '57

FORM 513-1 SUNRAY

FEB 13 1957

P. 10 Bopd + Tr. wtr.