


SECTION 15 TOWNSHIP 33S RANGE 3E

WELL NO. #2 Watts

COMPANY Crest Petroleum

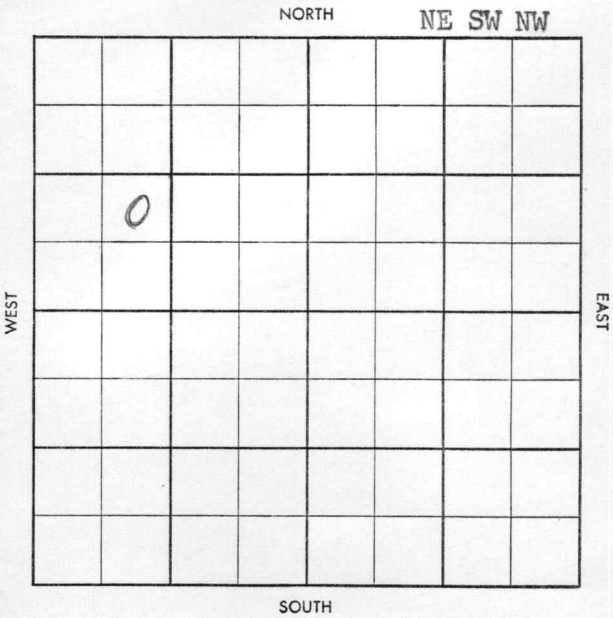

~~Watts Pool~~
~~Watts Pool~~

County Cowley Elev. _____
Sec. 15 Twp. 33 Rge. 3E
Company Crest Petroleum
Farm Name Watts No. 2

TOPS	DEPTH	LOG	DATUM
Anh.			
Tp.			
H.			
Tr.			
Dg.			
B.L.			
L.			
K.C.			
B.K.C.			
Ce.			
C.			
M.			
M.			
K.			
Mz.			
Mq.			
V.			
S.			
S.			
A.			
R.			
Pf.			
G.			
T.D.			

Loc. in Sec. _____
NE SW NW
1210' fsl
990' fwl NW
Geol. _____
Contr. _____
Wrico tools
Pool _____
Graham



Date Comm. _____
Location

Co.
Lse.
No.
Sec.
T.
R.

Twp. X Pool X
 Co. X Facet X

S-513-B

County Cowley Elev 1161 DF 1164 RB
 Sec. 15 Twp. 33 Rge. 3E
 Company Crest Petroleum
 Form Name Watts No. 2

TOPS	DEPTH	LOG	DATUM	Loc. in Sec.
Anh <u>Sta 1</u>	<u>2242</u>			<u>NE SW NW</u>
Tp. <u>Lay</u>	<u>2614</u>			
H.				<u>1210' fsl</u>
Tr.				<u>990' fwl NW</u>
Dg.				Geol.
B.L.				Contr.
L.				<u>Wrico tools</u>
K.C.	<u>2779</u>			Pool
B.K.C. <u>OSW</u>	<u>2970</u>			<u>Graham</u>
Ce.	<u>3080</u>			COMPLETE
C. <u>Styl zone</u>	<u>3240</u>			
M.	<u>3250</u>			o
M.				
K.				JUN 11 '58
Mz.				
Mg.				
V.				
S.				
S.				
A.				
R.				
Pf.				
G.				
T.D.	<u>3261</u>			

Date Comm. 4-25-58
 Location APR 30 '58 8" e 125 ø 1300
5" 3251 wocT MAY 1-4 '58 CO 3261
FU at rate 2 1/2 Boph tsy (4)
MAY 21 '58 P20 MAY 25 '58 \$7 Boph NW pop
JUN 3 '58 JUN 11 '58 P 27-30 Boph NW
P 25 Boph NW
⌘

Co. Sec. No. Sec. T. R.