


SECTION 15 TOWNSHIP 13 RANGE 17W

WELL NO. #1 Dorzweiler "E"


COMPANY K & E Drlg. & Kaiser

NORTH

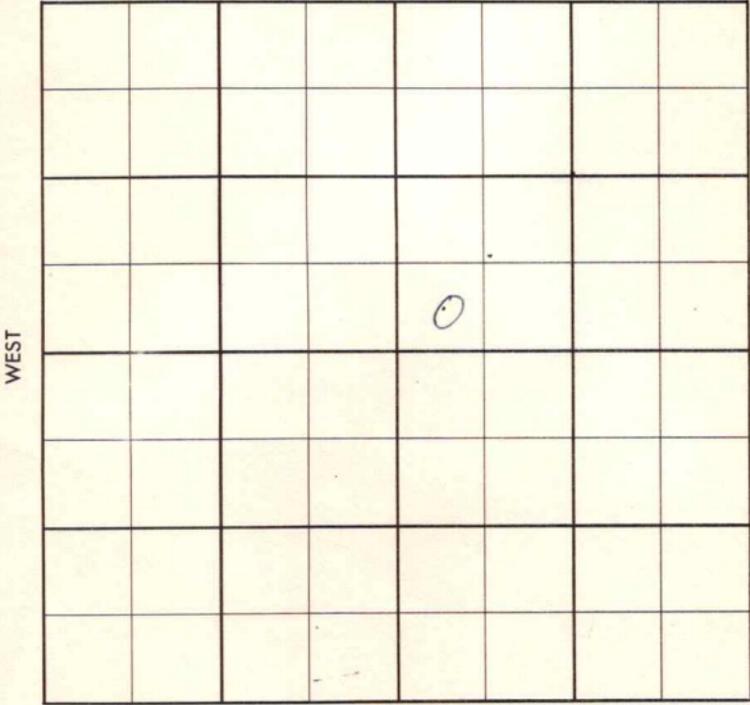

SOUTH

150015

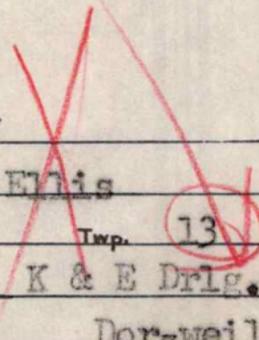

County Ellis Elev. _____
 Sec. 15 Twp. 13 Rge. 17W
 Company K & E Drig. & Kaiser
 Farm Name Dorzweiler "E" No. 1

Co.

TOPS	DEPTH	LOG	DATUM	Loc. in Sec.
Anh.	1200			SW SW NE
TP.				
H.				
Tr.				
Dg.				
BL.				
L.				Geol. _____
K.C.				Contr. _____
B.K.C.				
Ce.				<u>K & E</u>
C.				
M.				Pool _____
M.				<u>Karlin</u>
K.				
Mz.				
Mo.				
V.				
S.				
S.				
A.				
R.				
Pe.				
G.				
T.D.				

Lse.




No.

Date Comm. 1-12-57
8" @ 167/125 drlg. 1900

Sec.

T.

R.

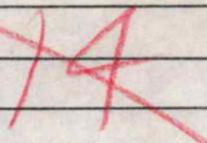


County Ellis Elev. 21996
 Sec. 15 Twp. 13 Rge. 17W
 Company K & E Drilling & Kaiser
 Farm Name Dorweiler "E" No. 1

TOPS	DEPTH	LOG	DATUM	Loc. in Sec.
Anb.	1200			SW SW NE
Tr.	3231			
Tr.	3252			
Dg.				
Bl.				
L.	3276			Geol.
K.C.				Contr.
B.K.C.	3508			K & E
Ce.				Pool
C. <u>cherty</u>	3524			Kerlin
M.				
M.				
K.				
Mz.				
Ma.				
V.				
S.				
S.				
A. <u>Rework</u>	3574			
R.				
Pe.				
G.				
T.D.	3597			ABANDONED

Date Comm. 1-12-57
8" @ 167/125 drlg. 1900

D. E. A.

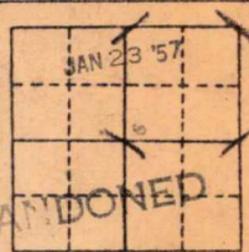

Co.
Lse.
No.
Sec.
T.
R.