

KANSAS

FORM 51 5M 1-42 PETROL


Sumner

Section 18 Township 30 Range 1-E

Well No. 1 Sargent

Company Waite Phillips

NORTH Zyba Pool

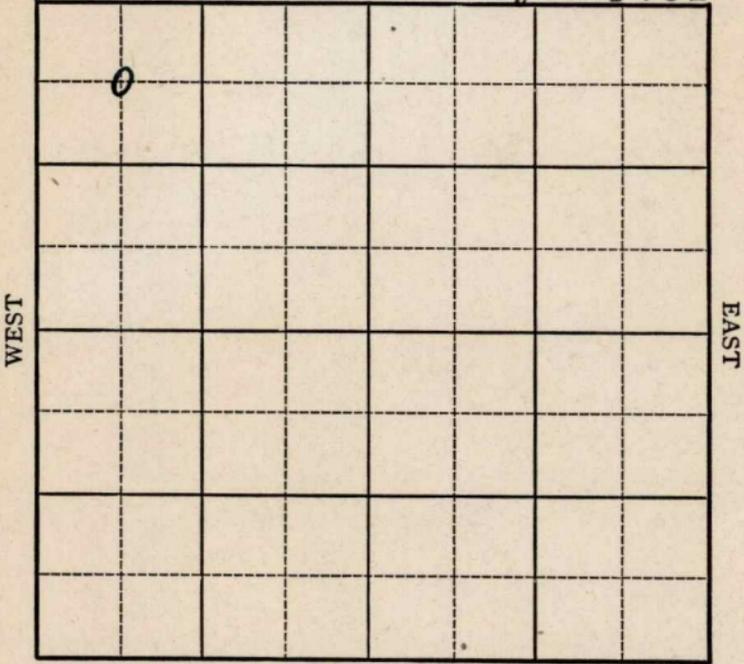

KANSAS

Sumner

Sec 18 Twp. 30 R. 1-E

Well No. #1 Sargent Farm

Waite Phillips Company


(Zyba)

660 Ft. from N. Line

_____ Ft. from S. Line

_____ Ft. from E. Line

660 Ft. from W. Line

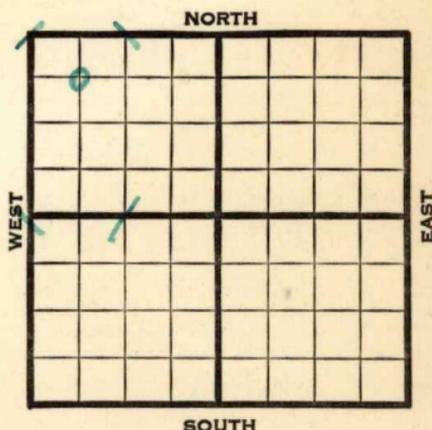

Elev. 1237

1942	REPORT
2/11	Location
2/19	Derrick.
2/26	12" - 40' Drlg. 210'
3/5	8" - 270' Drlg. 800'
3/12	K.C. 2815' Drlg. 3040'
3/19	Drlg. 3608'
3/26	Miss. 3408' B. Miss. 3810'
	5" - 3843' RUST.
4/1	Misener 3853'
	Simp. 3867'
	Sand 3983'
	T.D. 4006'
	No shows.
	ABANDONED

Map No. 12 Sec. 18 Twp. 30 R. 1E

Well No. 1 Sargent

Waite Phillip Company

FIRST REPORT

Contractor

C NW NW


660 Ft. from N. Line

_____ Ft. from S. Line

_____ Ft. from E. Line

660 Ft. from W. Line

SECTION PLAT

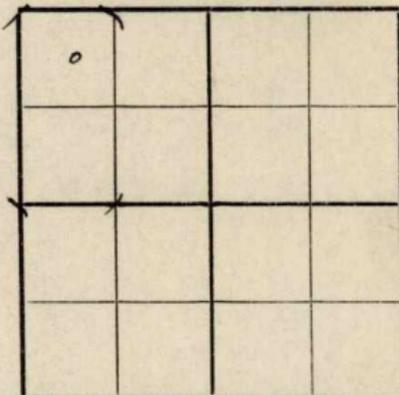

ZYBA POOL

Location XX

Rig up _____

Drilling and Remarks:

RECORD

Cased _____ in., _____ ft.

Sand _____

Gas _____

Oil _____

Total Depth _____

PRODUCTION

1st 24 hrs. Nat. _____

1st 24 hrs. after shot _____

Gas _____ Cu. Ft..

Dry Hole _____

Abandoned _____

Date

FEB 11 1942

19

S. J. LEWIS

Scout

KANSAS

Summer

Map No. 12 Sec. 18 Twp. 30 R. 1E

Well No. 1 Sargent

Waite Phillip Company

ABANDONED Contractor

SECTION PLAT

C NW NW

0			

660 Ft. from N. Line

_____ Ft. from S. Line

_____ Ft. from E. Line

660 Ft. from W. Line

ZYBA POOL

Location _____

Rig up _____

Drilling and Remarks:

Mud 3753

Sand 3767

Sand 3983

No show

RECORD

Cased _____ in., _____ ft.

Sand _____

Gas _____

Oil _____

Total Depth 4006

PRODUCTION

1st 24 hrs. Nat. _____

1st 24 hrs. after shot _____

Gas _____ Cu. Ft.

Dry Hole _____

Abandoned _____

Date

APR 1 1942 19

S. J. LEWIS Scout