


Sumner

KANSAS

SECTION 20 TOWNSHIP 30S RANGE 1E

WELL NO. #1 Downs

COMPANY Stelbar

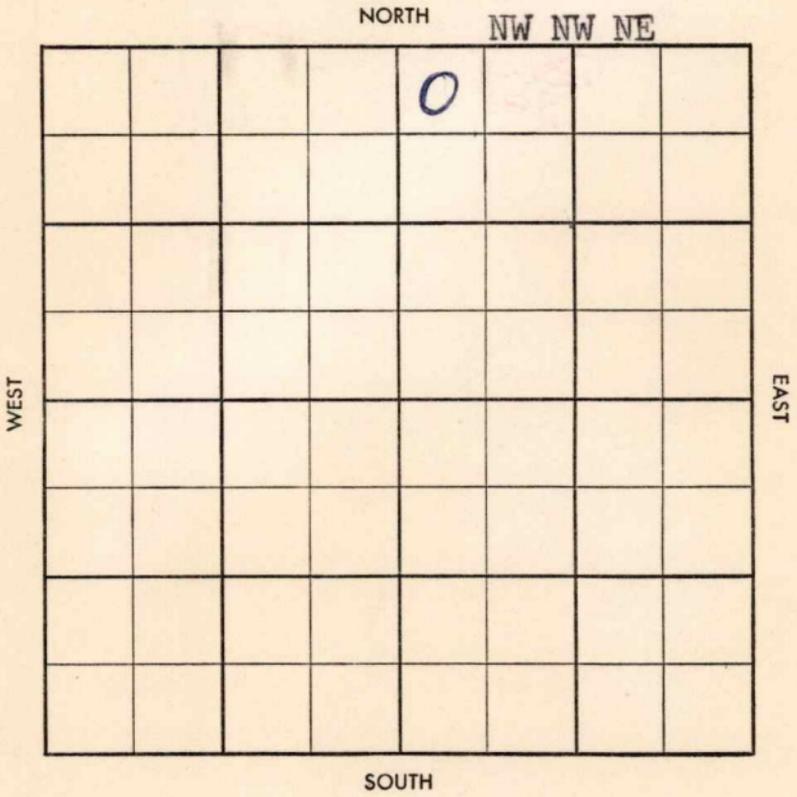

Twp. ~~_____~~ Pool ~~_____~~
 Co. ~~_____~~ Facet ~~_____~~

5-513-A

CO. Sumner ELEV. 1335
 SEC. 20 TWP. 30 RGE. 1E
 COMPANY Stelbar NO. 1

JUN 18 '58
 COMPLETE

FARM Downs
 LOC. NW NW NE

KC 2776
BKC 3018
M 3383
K 3763
554 3818
TD 3828

GEOL. _____
 CONTR. Co. Tools _____
 POOL Unnamed
 SPUD 1/13/58
8" @ a43 w/200
 WOC JAN 29 '58 \$3182
DST 3819
-28 60" g15"
ga 73 m of +sth
in 60" 2085' oil

120' SW F P 80-790 BHP
1395-30 ~~unit~~ 5" 3819
 FEB 5 '58 FEB 12 '58 CO 3828 \$50 B0 + 65
BW # 5 hrs pop FEB 19 '58
APR 2 '58 P42 B0 + 50 BW pd
MAR 19 '58 P48 B0 + 45 BW pd
APR 2 '58 APR 9 '58 PBTD 3826 1/2
P 40 B0 + 40 BW pd
 APR 23 '58 APR 30 '58 MAY 7 '58 MAY 14 '58 MAY 21 '58
 MAY 28 '58 JUN 3 '58 JUN 11 '58 JUN 18 '58

Phy P 28 B0 pd 1390 w
n 40°

CO.
LSE
NO.
SEC.
TWP.
RGE.

