


SECTION 21 TOWNSHIP 30S RANGE 1E

WELL NO. #1 Matzek

COMPANY Stelbar Oil

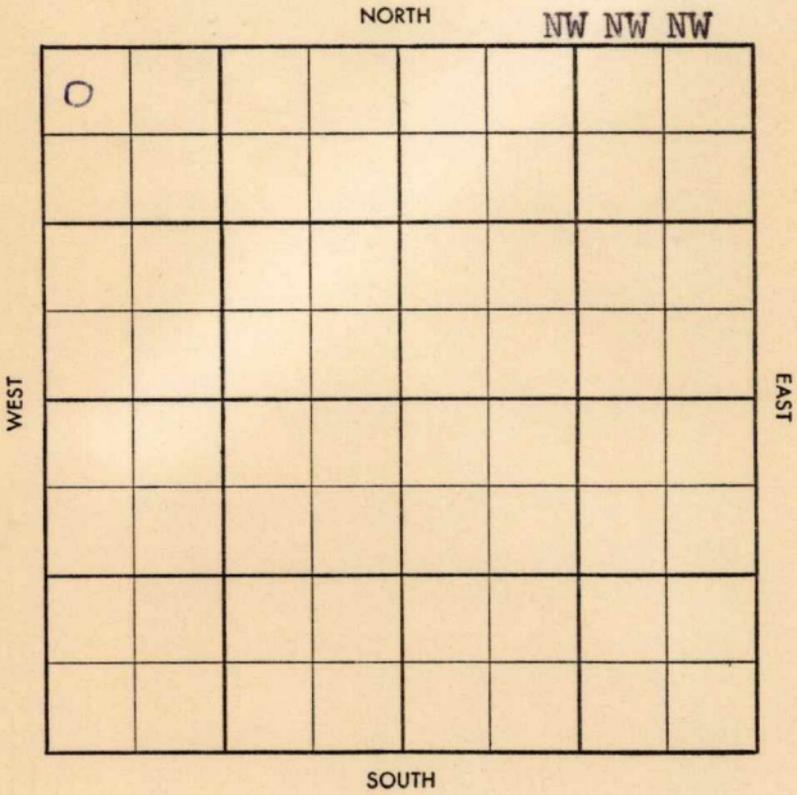

Twp. ~~_____~~ Pool ~~_____~~
 Co. ~~_____~~ Facet ~~_____~~

S-513-B

County Sumner Elev. _____
 Sec. 21 Twp. 30 Rge. 1E
 Company Stelbar Oil
 Farm Name Matzek No. 1

TOPS	DEPTH	LOG	DATUM
Anh.			
Tp.			
H.			
Tr.			
Dg.			
B.L.			
L.			
K.C.			
B.K.C.			
Ce.			
C.			
M.			
M.			
K.			
Mz.			
Mq.			
V.			
S.			
S.			
A.			
R.			
Pf.			
G.			
T.D.			

Loc. in Sec. _____
NW NW NW
 Geol. _____
 Contr. _____
Co. Tools #1
 Pool _____

JUN 3 1938
FIRST REPORT

Date Comm. _____
MIRT

Twp. ~~21~~ Pool ~~30~~

Co. ~~Stelbar~~ Facet ~~Oil~~

S-513-B

County Sumner Elev 13310 13344
 Sec. 21 Twp. 30 Rge. 1E
 Company Stelbar Oil
 Farm Name Matzek No. 1

TOPS	DEPTH	LOG	DATUM
Anh.			
Tp.			
H.			
Tr.			
Dg.			
B.L.			
L.			
K.C.	2759		
B.K.C.			
Ce.			
C.			
M. <u>Chart</u>	3369		
M. <u>L.</u>	3373		
K.	3757		
Mz.	3799		
Mq.			
V.			
S. <u>dojo</u>	3811		
S. <u>sd</u>	3836		
A.	3886		
R.			
Pf.			
G.			
T.D.	3931		

Loc. in Sec. NW NW NW
 Geol. _____
 Contr. _____
 Co. Tools # 1

Pool _____
 0
 JUN 18 58
ABANDONED

Date Comm. 6-2-58 8"225

MIRT JUN 11 58 3154 JUN 18 58 DST
3802-10 30" 3'M BHP 39 DST
3812 -15 35" 5'M BHP 39
no log

D&A

Co.
Lse
No.
Sec.
T.
R.