


Cowley

KANSAS

SECTION 15 TOWNSHIP 33S RANGE 3E

WELL NO. #1 C. Wright

COMPANY Crest Petroleum

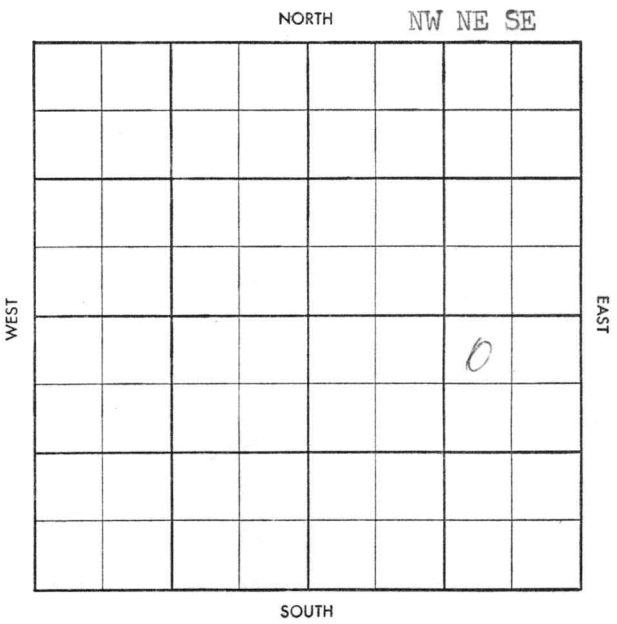

25

County Cowley Elev. _____
 Sec. 15 Twp. 33 Rge. 3E
 Company Crest Petroleum
 Farm Name C. Wright No. 1

TOPS	DEPTH	LOG	DATUM
Anh.			
Tp.			
H.			
Tr.			
Dg.			
B.L.			
L.			
K.C.			
B.K.C.			
Ce.			
C.			
M.			
M.			
K.			
Mz.			
Mq.			
V.			
S.			
S.			
A.			
R.			
Pf.			
G.			
T.D.			

Loc. in Sec. _____
NW NE SE
 Geol. _____
 Contr. _____
Wrico tools
 Pool _____
Graham



Date Comm. _____
8" @ 125, WOC

Co.
Lse.
No.
Sec.
T.
R.

County Cowley Elev 11660F 11690
 Sec. 15 Twp. 33 Rge. 3E
 Company Crest Petroleum
 Farm Name C. Wright No. 1

TOPS	DEPTH	LOG	DATUM	Loc. in Sec.
Anh. <u>Stal</u>	<u>2234</u>			NW NE SE
Tp.				
H. <u>Lay</u>	<u>2644</u>			
Tr.				
Dg.				
B.L.				
L.				Geol.
K.C.	<u>2322</u>			Contr.
B.K.C. <u>OSW</u>	<u>3012</u>			
Ce.				
C. <u>B7V1</u>	<u>3304</u>			<u>Wrico tools</u>
M.	<u>3311</u>			Pool
M.				<u>Graham</u>
K.				
Mz.				
Mq.				
V.				
S.				
S.				
A.				
R.				
Pf.				
G.				
T.D.	<u>3325</u>	<u>1</u>		

ABANDONED

MAR 12 '58

Date Comm. 2-24-588" @ 125, WOC 3305 3200 MAR 12 '58DST 3305-25 @ 90" 70'M60' WM FPO-60 BHP 775/30"

D6A