

Ellis

KANSAS

SECTION 15 TOWNSHIP 13 RANGE 17 W

WELL NO. #1 Dreiling "D"

COMPANY Leo Dreiling

NORTH

WEST

EAST

					0		

SOUTH

10

Ellis

KANSAS

SEC.	TWP.	R.
15	13	17W

WELL NO.

#1 Dreiling "D"

FARM

COMPANY

Leo Dreiling

CONTRACTOR

Garvey

Catherine


Ft. from N. Line

Ft. from S. Line

Ft. from E. Line

Ft. from W. Line

NE NW SE

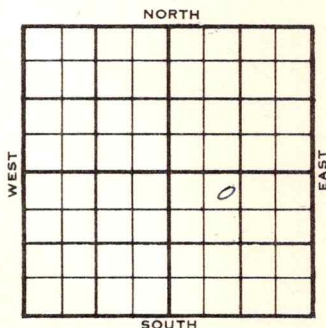

	ELEVATION	REPORT
1955	1996'	


11-23 Comm. 11-19-55
8" @ 137
Drlg. 1575

11-30 D & A
Anh. 1148
H. 3214
Tr. 3236
L. 3260
C. 3521
TD 3550'

ABANDONED

County Ellis Elev. 1996
 Sec. 15 Twp. 13 Rge. 17W
 Company Leo Dreiling
 Farm Name Dreiling "D" No. 1

TOPS	DEPTH	LOG	DATUM	Loc. in Sec.
Anh.				NE NW SE
Tp.				
H.				
Tr.				
Dg.				
Bl.				
L.				Geol.
K.C.				Contr.
B.K.C.				Garvey
Ce.				
C.				Pool
M.				Catherine
M.				
K.				
Mz.				
Mq.				
V.				
S.				
S.				
A.				
R.				
PE.				
G.				
T.D.				

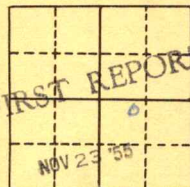

Date Comm. 11-19-55
8" @ 137 drlg. 1575

[Red handwritten mark, possibly '84', is visible at the bottom of the page.]

County Ellis Elev. 1996
 Sec. 15 Twp. 13 Rge. 17W
 Company Leo Dreiling
 Farm Name Dreiling "D" No. 1

TOPS	DEPTH	LOG	DATUM	Loc. in Sec.
Anh.	1148			NE NW SE
TP.				
H.	3214		1218	
Tr.	3236		1240	
Dg.				
BL.				
L.	3260		1264	Geol.
K.C.				
B.K.C.				Contr.
Ce.				
C.	3521		1525	Garvey
M.				
M.				Pool
K.				
Mz.				Catherine
Me.				
V.				
S.				
S.				
A.				
R.				
PE.				
G.				
T.D.	3550			

Lse.

No.

ABANDONED

Date Comm.	11-19-55	NOV 30 1955	Sec.
8" @ 137			

D & A

五