

KANSAS


FORM 51 5M PETROL

Summer

Section 35 Township 30 Range 1-E

Well No. #1 Gilbert

Company Barnsdall

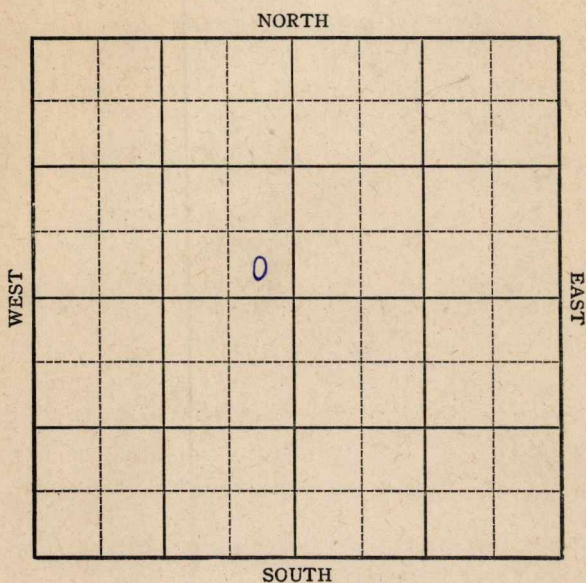

Sec. 35 Twp. 30 R. 1-E

Well No. #1 Gilbert Farm

Barnsdall Company


         Ft. from N. Line

330 Ft. from S. Line

330 Ft. from E. Line

         Ft. from W. Line

Elev. 1217

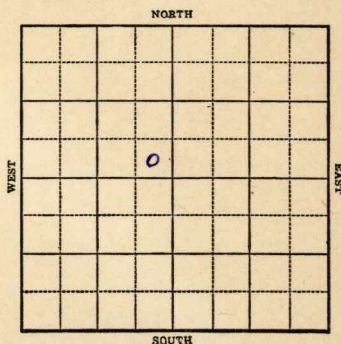

1943

R E P O R T

10/6 Rotary  
10/13 9" @ 202  
Drlg. 2026'  
10/20 Drlg. 3300'  
10/27 Miss 3302  
Drlg. 3622  
11/4 Drlg. 3929'  
11/10 4159' SM  
11/17 KC 2705  
Miss 3303  
B. Miss 3570  
Arb 3683  
T.D. 4156'

KC 2705  
1217  
1488

3302  
1217  
-2085

3570  
1217  
-2353

Arb 3683  
1217  
2466

ABANDONED

**KANSAS**Map No. 12 Sec. 35 Twp. 30 R. 1EWell No. 1 GilbertBarnsdall CompanyABANDONED Contractor

SE NW

## SECTION PLAT

|  |  |   |  |
|--|--|---|--|
|  |  |   |  |
|  |  |   |  |
|  |  | 2 |  |
|  |  |   |  |
|  |  |   |  |

       Ft. from N. Line330 Ft. from S. Line330 Ft. from E. Line       Ft. from W. Line**Wildcat**Location                                 Rig up                                 

Drilling and Remarks:

*HC 2705**Misc 3303**B Misc 3570**Cr 73683*

## RECORD

Cased            in.,            ft.Sand                                 Gas                                 Oil                                 Total Depth 4156

## PRODUCTION

1st 24 hrs. Nat.                                 1st 24 hrs. after shot                                 Gas                                  Cu. Ft.Dry Hole                                 Abandoned                                 

Date

NOV 17 1943 19 S. J. LEWIS Scout

KANSAS

Map No. 12 Sec. 35 Twp. 30 R. 1EWell No. 1 GilbertBarnsdall

Company

FIRST REPORT

Contractor

SE NW

## SECTION PLAT

Ft. from N. Line


330

Ft. from S. Line

330

Ft. from E. Line

Ft. from W. Line

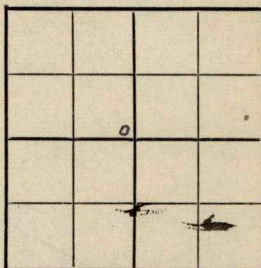Wildcat

Location

Rig up

Drilling and Remarks:

Rotary

## RECORD

Cased \_\_\_\_\_ in., \_\_\_\_\_ ft.

Sand \_\_\_\_\_

Gas \_\_\_\_\_

Oil \_\_\_\_\_

Total Depth \_\_\_\_\_

## PRODUCTION

1st 24 hrs. Nat. \_\_\_\_\_

1st 24 hrs. after shot \_\_\_\_\_

Gas \_\_\_\_\_ Cu. Ft.

Dry Hole \_\_\_\_\_

Abandoned \_\_\_\_\_

Date

OCT 6 1943 19

S. J. LEWIS

Scout