


Summer County, Kansas

Section 5 Township 30S^b Range 2E

Well No. #1 Kersey B

Company J. P. Gaty

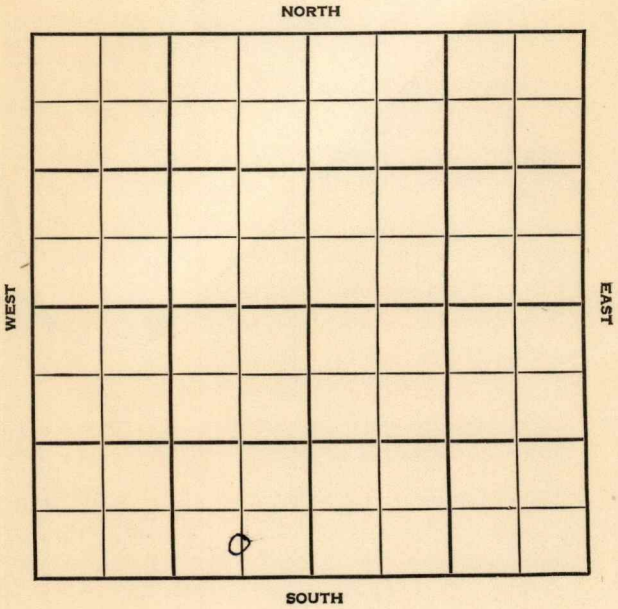

Sumner

KANSAS

SEC. 5	TWP. 30	R. 2E
-----------	------------	----------


WELL NO. #1 Kersey "B" FARM

COMPANY J.P. Gaty

CONTRACTOR Morrison

WILDCAT

_____ Ft. from N. Line
 _____ Ft. from S. Line
 _____ Ft. from E. Line
 _____ Ft. from W. Line

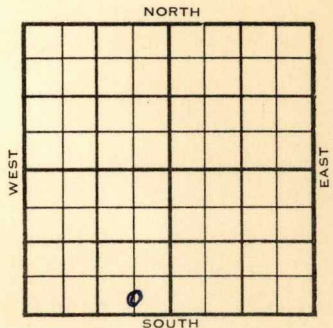

C S $\frac{1}{2}$ SE SW

1955	ELEVATION 1229' RB	REPORT
------	-----------------------	--------

9-14 Cellar & pits
 1956

1-11 5 $\frac{1}{2}$ " @ 3566
 DD 3593
 HFW
 PB 3170, 40/ 3150-60, 250 A
 P/ 10 bopd, 60 BW, oil decreased
 D & A
 KC. 2607
 Marm. 2843
 C. 3122
 M. 3135
 K. 3471
 S. 3538
 A. 3585
 TD 3586'

ABANDONED

1227 DF

County **Sumner**

Elev. **1229 RB**

Sec. **5** Twp. **30**

Rge. **2E**

Company **J. P. Gaty**

Farm Name **Kersey "B"**

No. **1**

Co.

Lse.

No.

Sec.

T.

R.

TOPS	DEPTH	LOG	DATUM
Anh.			
Tp.			
H.			
Tr.			
Dg.			
Bl.			
L.			
K.C.	2607		1378
B.K.C. <i>Marm</i>	2843		1614
Ce.			
C.	3122		1893
M.	3135		1904
M.			
K.	3471		2242
Mz.			
Mq.			
V.			
S.	3538		2309
S.			
A	3585		2356
R.			
PE.			
G.			
T.D.	3586		

Loc. in Sec. **C S $\frac{1}{2}$ SE SW**

Geol. **Morrison**

Pool **Wildcat**



Date Comm. **JAN 1 1 1956**

5 $\frac{1}{2}$ " @ 3566 DD 3593 HFW PB 3170

40/ 3150-60 250 A P/ 10 bopd 60 bw

oil decreased

D & A

County **Sumner** Elev. **1229 RB**
 Sec. **5** Twp. **30** Rge. **2E**
 Company **J. P. Gaty**
 Farm Name **Kersey "B"** No. **1**

TOPS	DEPTH	LOG	DATUM
Anh.			
TP.			
H.			
Tr.			
Dg.			
Bl.			
L.			
K.C.			
B.K.C.			
Ce.			
C.			
M.			
M.			
K.			
Mz.			
Ma.			
V.			
S.			
S.			
A.			
R.			
PE.			
G.			
T.D.			

Loc. in Sec. **C S $\frac{1}{2}$ SE SW**

Geol. **Morrison**
 Contr. **Wilcoat**
 Pool

SEP 14 '45
FIRST REPORT

Date Comm. **Cellar & pits**

Co.
Lse.
No.
Sec.
T.
R.