

Sumner


KANSAS

SECTION 14 TOWNSHIP 30 RANGE 2E

WELL NO. #1 Morden

COMPANY Aurora Gasoline

NORTH

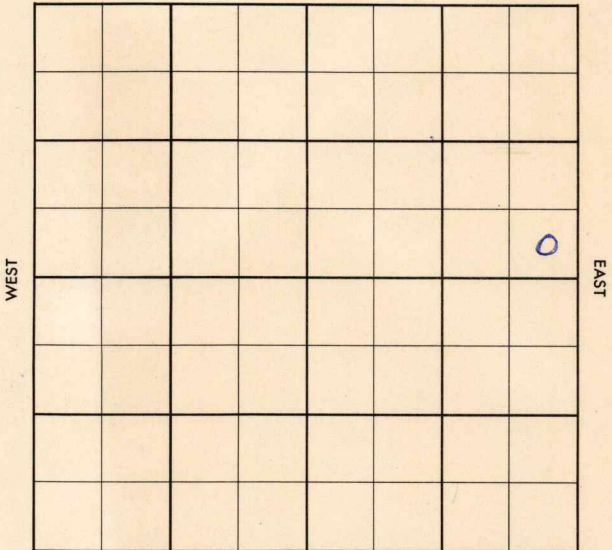

SOUTH

Sumner

KANSAS

SEC. 14	TWP. 30	R. 2E
------------	------------	----------

WELL NO.

// #1 Morden

FARM

COMPANY

Aurora Gasoline

CONTRACTOR

Kriswell

WILDCAT


Ft. from N. Line

Ft. from S. Line

Ft. from E. Line

Ft. from W. Line

SE SE NE

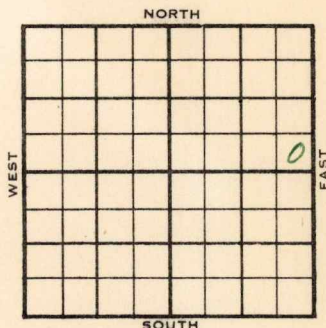

Shell - DHM

1956

ELEVATION

1274'

REPORT

5-9

Comm. 5-3-56

8" @ 109

Drlg. 1970

5-16

DST 3106-32 op 30 min. rec. 10' mud,
BHP 1000/20

DST 3508-15 op 1 hr. 3085' SW, BHP
1385/30"

D & A

TD 3561'

Log tops: Stall 2226', KC. 2565',

BKC 2818', Ce. 2846', M. 3105',

K. 3402', Chata 3440', S. 3498',

A. 3506'.

ABANDONED

County Summer Elev. _____
Sec. 14 Twp. 30 Rge. 2E
Company Aurora Gasoline
Farm Name Morden No. 1

TOPS	DEPTH	LOG	DATUM	Loc. in Sec.
Anh.				SE SE NE
Tp.				
H.				
Tr.				
Dg.				
BL.				
L.				Geol.
K.C.				Contr.
B.K.C.				Kriswell
Ce.				
C.				Pool
M.				Wildcat
M.				
K.				
Mz.				
Mq.				
V.				
S.				
S.				
A.				
R.				
P.				
G.				
T.D.				

Date Comm. 5-3-56 Shell - DHM
8" @ 109 drlg. 1970

27
R. C. I. YAM
R. C.

County Sumner Elev. 1274
 Sec. 11 Twp. 30 Rge. 2E
 Company Aurora Gasoline
 Farm Name Morden No. 1

TOPS	DEPTH	LOG	DATUM	Loc. in Sec.
Anh.				SE SE NE
Tp. <u>Stall</u>		<u>2226</u>		
H.				
Tr.				
Dg.				
BL.				
L.				
K.C.		<u>2565</u>		Geol.
B.K.C.		<u>2818</u>		Contr.
Ce.		<u>2846</u>		<u>Kriswell</u>
C.				
M.		<u>3105</u>		Pool
M.				
K.		<u>3402</u>		
Ms. <u>chata</u>		<u>3440</u>		<u>Wildcat</u>
Me.				
V.				
S.		<u>3498</u>		
S.				
A.		<u>3506</u>		
R.				
Pe.				
G.				
ID.	<u>3561</u>			

ABANDONED

MAY 16 1956

Date Comm. 5-3-56 Shell - DHM

8" @ 109 drlg. 1970 MAY 15 56 DST

3106-32 30" net 10' Md BHP

1000/20 DST 3508-15 1hr. 3085' SW

BHP 1385/30"

D&A