


Map No. *Kans* Sec. *23* Twp. *30 R 2 E*
Well No. *1 - Maurice* Farm
Philmac Company

..... Ft. from N. Line
300 Ft. from S. Line
..... Ft. from E. Line
300 Ft. from W. Line

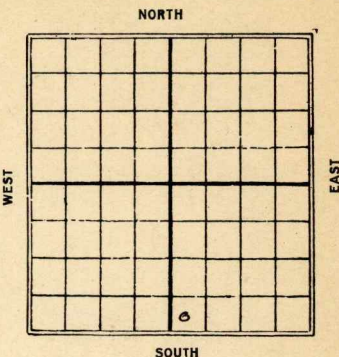

1926

Date REPORT *1293*

<i>10/13</i>	<i>location</i>
<i>10/20</i>	<i>R.O.G.</i>
<i>10/27</i>	<i>rig</i>
<i>11/3</i>	<i>spud</i>
<i>11/10</i>	<i>Drlg 350</i>
<i>11/17</i>	<i>" 400</i>
<i>11/24</i>	<i>" 1100</i>
<i>12/1</i>	<i>" 1675</i>
<i>12/8</i>	<i>" 2225'</i>
<i>12/15</i>	<i>" 2375'</i>
<i>12/21</i>	<i>" 2738 str R. H.F.W.</i>
<i>12/29</i>	<i>S.D.</i>
<i>1927</i>	
<i>1/5</i>	<i>Drilling 2930</i>
<i>1/12</i>	<i>top line 3155 - Drlg 3400</i>
<i>1/19</i>	<i>Drlg - 3445</i>
<i>1/26</i>	<i>Wilcox 3565 to 3600 H.F.W.</i>
	<i>Drlg 3645 in line</i>
<i>2/2</i>	<i>Drlg 3755</i>
<i>2/9</i>	<i>J.D. 3744 - S.L.M.</i>
	<i>D.O.A.</i>

12 *Summit*
 Map No. **KANSAS** Sec. *23* Twp. *30* • R. *2E*

Well No. *1 Annie*

Philmac Company

Contractor

SECTION PLAT

----- Ft. from N. Line

300 Ft. from S. Line

----- Ft. from E. Line

300 Ft. from W. Line

		0	


FIRST REPORTS

Location -----

Rig up -----

Drilling and Remarks:

Location.

 

RECORD

Cased ----- in., ----- ft.

Sand -----

Gas -----

Oil -----

Total Depth -----

PRODUCTION

1st 24 hrs. Nat. -----

1st 24 hrs. after shot -----

Gas ----- Cu. Ft.

Dry Hole -----

Abandoned -----

Date

OCT 13 1926

S. J. LEWIS Scout

12
Map No. KANSAS Sec. 23 Twp. 30 R. 2E

Well No. 1 Maurie

Philmac Company

Contractor

SECTION PLAT

----- Ft. from N. Line

300 Ft. from S. Line

----- Ft. from E. Line

300 Ft. from W. Line

ABANDONED

		0	

Location -----

Rig up -----

Drilling and Remarks:

TJ 3744 Bl. M.

II & A.

RECORD

Cased ----- in., ----- ft.

Sand -----

Gas -----

Oil -----

Total Depth -----

PRODUCTION

1st 24 hrs. Nat. -----

1st 24 hrs. after shot -----

Gas ----- Cu. Ft.

Dry Hole -----

Abandoned -----

Date

FEB 9 1927

192

S. J. LEWIS

Scout

Summer

K12 MAP No. **KANSAS** SEC. 23 TWP. 30S R. 2E

WELL No. _____
Mauroie
Philivach COMPANY

CONTRACTOR

SECTION PLAT

_____ FT. FROM N. LINE

_____ FT. FROM S. LINE

_____ FT. FROM E. LINE

_____ FT. FROM W. LINE

LOCATION _____

RIG UP _____

DRILLING AND REMARKS:

*well shall
3744*

RECORD

CASED _____ IN., _____ FT.

SAND _____

GAS _____

OIL _____

TOTAL DEPTH 3755

PRODUCTION

1ST 24 HRS. NAT. _____

1ST 24 HRS. AFTER SHOT _____

GAS _____ CU. FT.

DRY HOLE

ABANDONED

DATE

7/1 192 7

SCOUT