



Map No. Land Sec. 30 Twp. 30 R. 2E

Well No. 1 alters Farm


Phil-mac Oil Company

300 Ft. from N. Line

\_\_\_\_\_ Ft. from S. Line

\_\_\_\_\_ Ft. from E. Line

300 Ft. from W. Line

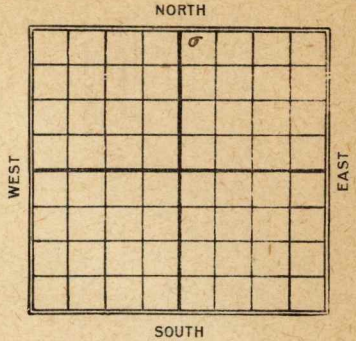

1926

Date \_\_\_\_\_ REPORT 1206

<u>9/29</u>	<u>Location</u>
<u>10/6</u>	<u>Same</u>
<u>10/13</u>	_____
<u>10/20</u>	_____
<u>10/27</u>	<u>Rigging up</u>
<u>11/3</u>	<u>Spud</u>
<u>11/10</u>	<u>Drlg 470</u>
<u>11/17</u>	<u>" 695</u>
<u>11/24</u>	<u>" 1304 Set 12 1/2"</u>
<u>12/1</u>	<u>" 1865</u>
<u>12/8</u>	<u>" 2120</u>
<u>12/15</u>	<u>24 17'-25' H.F.W. Drlg 2467'</u>
<u>12/21</u>	<u>Drilling 2725</u>
<u>12/29</u>	<u>S.D.</u>
<u>1927</u>	
<u>1/5</u>	<u>Drlg - 2950</u>
<u>1/12</u>	<u>" 3038</u>
<u>1/19</u>	<u>T.D. 3095 UR. 6"</u>
<u>1/26</u>	<u>Drlg 3172</u>
<u>2/2</u>	<u>Chat 3250 to 65 show oil</u> <u>top line 3290 - drlg</u>
<u>2/9</u>	<u>Drilling 3320</u>

2/16 - Drilling 3509

2/22 - Baseline 3578

3705 - H. F. W.

J. D. 3710

D. & A.

*Summer*

K12 MAP NO. **KANSAS** SEC. *30* TWP. *30S* R. *2E*

WELL NO. *1 alte*

*Philman*

COMPANY

CONTRACTOR

SECTION PLAT

		0	

\_\_\_\_\_ FT. FROM N. LINE

\_\_\_\_\_ FT. FROM S. LINE

\_\_\_\_\_ FT. FROM E. LINE

\_\_\_\_\_ FT. FROM W. LINE

LOCATION \_\_\_\_\_

RIG UP \_\_\_\_\_

DRILLING AND REMARKS:

*3680 } oil line  
3705 } shows  
oil*

*H. J. W.*

*we show  
3710*

RECORD

CASED \_\_\_\_\_ IN. \_\_\_\_\_ FT.

SAND \_\_\_\_\_

GAS \_\_\_\_\_

OIL \_\_\_\_\_

TOTAL DEPTH *3705*

PRODUCTION

1ST 24 HRS. NAT. \_\_\_\_\_

1ST 24 HRS. AFTER SHOT \_\_\_\_\_

GAS \_\_\_\_\_ CU. FT.

DRY HOLE

ABANDONED \_\_\_\_\_

DATE

*2/23*

192

*7*

SCOUT

12 *Summer*  
Map No. **KANSAS** Sec. *30* Twp. *30* R. *2E*

Well No. *1 Alters*

*Phil Mac Oil* Company

Contractor

**SECTION PLAT**

*300* Ft. from N. Line

----- Ft. from S. Line

----- Ft. from E. Line

*300* Ft. from W. Line

		0	

**FIRST REPORTS**

Location -----

Rig up -----

Drilling and Remarks:

*Location*

**RECORD**

Cased ----- in., ----- ft.

Sand -----

Gas -----

Oil -----

Total Depth -----

**PRODUCTION**

1st 24 hrs. Nat. -----

1st 24 hrs. after shot -----

Gas ----- Cu. Ft.

Dry Hole -----

Abandoned -----

Date

*SEP 29 1926*  
192

**S. J. LEWIS**

Scout

*Sumner*  
12  
Map No. **KANSAS** Sec. *30* Twp. *30* R. *2E*

Well No. *1 Alters*

*Philmac Oil* Company

Contractor

SECTION PLAT

*200* Ft. from N. Line

\_\_\_\_\_ Ft. from S. Line

\_\_\_\_\_ Ft. from E. Line

*300* Ft. from W. Line

		0	

**ABANDONED**

Location \_\_\_\_\_

Rig up \_\_\_\_\_

Drilling and Remarks:

*Base line c 3578*

*3705 HFW*

*TII 3710*

*I & A*

RECORD

Cased \_\_\_\_\_ in., \_\_\_\_\_ ft.

Sand \_\_\_\_\_

Gas \_\_\_\_\_

Oil \_\_\_\_\_

Total Depth \_\_\_\_\_

PRODUCTION

1st 24 hrs. Nat. \_\_\_\_\_

1st 24 hrs. after shot \_\_\_\_\_

Gas \_\_\_\_\_ Cu. Ft.

Dry Hole \_\_\_\_\_

Abandoned \_\_\_\_\_

Date

FEB 23 1927

192

S. J. LEWIS

Scout