

Section 20 Township 17 Range 13WWell No. 1 McIlwaineCompany M. B. Armer

NORTH

			0				

WEST

EAST

SOUTH

Barton

KANSAS

Sec. 20 Twp. 17 R. 13 W

Well No. # 1 McIlwaine Farm

M. B. Armer Company

Wildcat Contractor

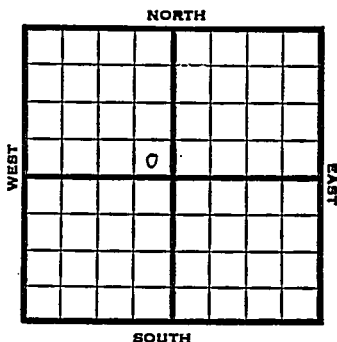
Ft. from N. Line

330 Ft. from S. Line

330 Ft. from E. Line

Ft. from W. Line

SE SE NW
Magnolia Farmout



1951

Elev. 1909' REPORT

7/18

R U R

8/1

Spud 7-17-51

D & A TD 3441' 8" @ 194

Anhy 867-95' Heeb 3085' Tor. 3107'

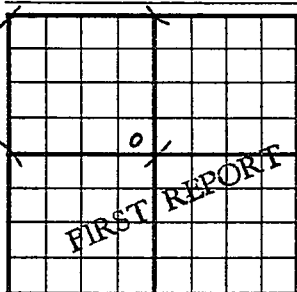
Br. line 3167' Lans. 3179'

DST 3182-3200 open 45 min. rec 12' SOCM

Cong. 3391' Arb. 3420-41' TD

D & A

ABANDONED

County Barton State KansasSec. 20 (Blk. Twp.) 17 (Sur. Rge.) 13W Map No.Operator M. B. ArmerWell No. 1 Farm McIlwaineElev. Location SE SE NW330 Ft. From S Line NW330 Ft. From E Line Quarter1st. Report JUL 18 1951

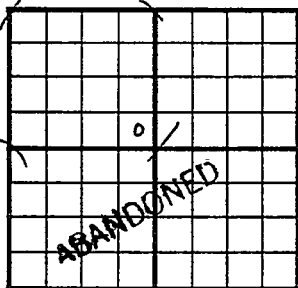
Completion

Remarks Magnolia farmout

Spudding Date

Drlg. Data WildcatR U R

J. E. TYRA

County Barton State KansasSec. 20 (Blk.
Twp.) 17 (Sur.
Rge.) 13W Map No.Operator M. B. ArmerWell No. 1 Farm McIlwaineElev. 1909 Location SE SE NW330 Ft. From S Line NW330 Ft. From E Line Quarter

1st. Report

Completion AUG 1 1951Remarks WildcatSpudding Date 7-17-51Drilg. Data D & A TD 34418" @ 194 Anhy 867-95 Heeb. 3085Tor. 3107 Br. lime 3167 Lans. 3179DST 3182-3200 open 45 min. Rec. 12' socmCong. 3391 Arb. 3420-41 TDD & A

J. E. TYRA