


KANSAS

Barton

Section 21 Township 17 Range 13-W
Well No. 1 Soderstorm (*Soderstrom*)
Company Atlantic Refining

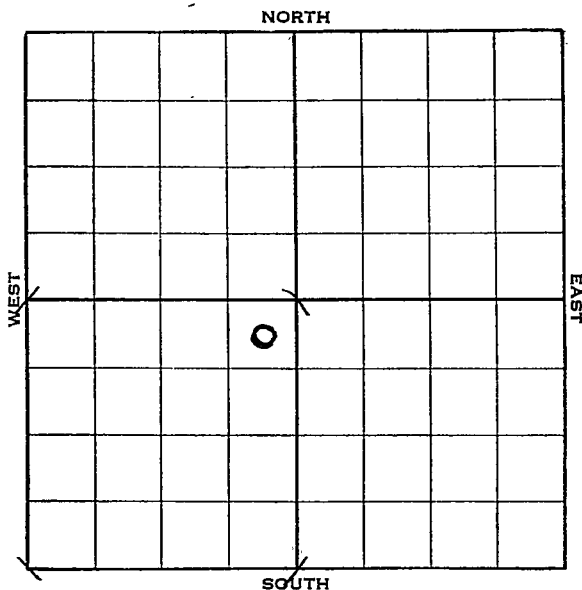

O. W. D. D

Sec. 21 Twp. 17 R. 13-W

Well No. #1 Soderstrom Farm
Atlantic Refg. Company


330 Ft. from N. Line

Ft. from S. Line

330 Ft. from E. Line

Ft. from W. Line

Elev. 1949

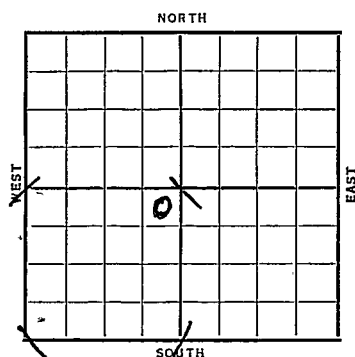

Date	REPORT O. W. D. D
1938	
3/9	Location
3/18	R. U. C. T.
3/25	" "
4/1	15" @ 350'.
4/8	12" @ 627'. Anhy 886'.
	10" @ 894'. Drlg. 1150'.
4/15	Drlg. 2060'.
4/22	8" @ 2250'. Drlg. 2585'.
4/29	8" @ 2541'. T.D. 2625'.
	U.R. 8".
5/6	8" @ 2630'. Topeka 2825'.
	Drlg. 2925'.
5/12	Lans. 3193'. 7" @ 3219'.
	T.D. 3254'. 200' oil.
5/20	1/4 bailer oil & 1/2 bailer wtr. per hr. P.B. 3252'.
	150' fluid.
5/27	6000 acid. Pump 6 oil per hr.
	8 hrs. 10% wtr. 8000 acid.
	OVER



1938

6/1 7" @ 3219'..
Lans. 3193'.
T.D. 3254'.
P.B. 3252'.
6000 acid.
8000 acid.
Potential 340 bbls. oil & 20
water.

COMPLETED

1938

O. W. D. D

7/6 Old T. D. 3254'.
6" - 3219'.
Drlg. 3285'.
7/15 5" - 3419'. Arb. 3436'.
T. D. 3455'. 2 bbls. oil & 2½
bbls. water per hour. S.D.O.
7/22 5" - 3436'. WOC.
7/29 " " "
8/5 T.D. 3446'. 2000 acid.
8/12 SD 3446'.
8/19 " "
8/26 " "
9/2 " "
9/9 " "
9/16 " "
9/23 " "
9/30 " " OVER

1938

10/5 5" - at 3436'.

Arb. 3436'.

T. D. 3446'.

2000 acid.

Pump 28 oil and 88% water in
24 hours.

COMPLETED

Map No. _____ Sec. 21 Twp. 17 R. 13WWell No. 1 SoderstromAtlantic Refining Company

Contractor

FIRST REPORT

NE SW


330 Ft. from N. Line

_____ Ft. from S. Line

330 Ft. from E. Line

_____ Ft. from W. Line

SECTION PLAT

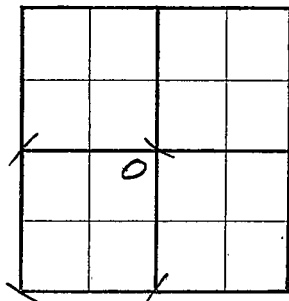Location X

Rig up _____

Drilling and Remarks:

RECORD

Cased _____ in., _____ ft.

Sand _____

Gas _____

Oil _____

Total Depth _____

PRODUCTION

1st 24 hrs. Nat. _____

1st 24 hrs. after shot _____

Gas _____ Cu. Ft.

Dry Hole _____

Abandoned _____

Date

MAR 9 - 1938

19

H. D. Hatfield

Scout

Barton

KANSAS

Map No. 73 Sec. 21 Twp. 17 R. 13WWell No. 1 SoderstromAtlantic Refining Company

Contractor

COMPLETED

SECTION PLAT

NE SW

330 Ft. from N. Line Ft. from S. Line330 Ft. from E. Line Ft. from W. Line

	0		

Location Rig up

Drilling and Remarks:

P.B. 3252
 6000 Acid
 8000 Acid
 Pot 340 oil
 20 wtr

RECORD

Cased 7 in., 3219 ft.Sand LENS 3193Gas Oil Total Depth 3254

PRODUCTION

1st 24 hrs. Nat. 1st 24 hrs. after shot Gas Cu. Ft.Dry Hole Abandoned

Date

JUN 1 - 1938

19

H. D. Hatfield Scout

Barton KANSAS

Map No. 73 Sec. 21 Twp. 17 R. 13WWell No. 1 SoderstromAtlantic Refining

Company

Contractor

FIRST REPORT

NE SW

330 Ft. from N. Line

Ft. from S. Line

330 Ft. from E. Line

Ft. from W. Line

SECTION PLAT

	0		

Location

Rig up

Drilling and Remarks:

OWDD-OTD 3254

6" - 3219

Dr1g. 3285

RECORD

Cased _____ in., _____ ft.

Sand _____

Gas _____

Oil _____

Total Depth _____

PRODUCTION

1st 24 hrs. Nat. _____

1st 24 hrs. after shot _____

Gas _____ Cu. Ft.

Dry Hole _____

Abandoned _____

Date

JUL 6 - 1938 19

H. D. Hatfield Scout

Barton KANSAS

Map No. 73 Sec. 21 Twp. 17 R. 13WWell No. 1 Soderstrom

Atlantic Refining Company

Contractor

COMPLETED

NE SW

330 Ft. from N. Line

Ft. from S. Line

330 Ft. from E. Line

Ft. from W. Line

SECTION PLAT

	O		

Location

Rig up

Drilling and Remarks:

*2000 acid**Run 28 oil
and 88% wtr
in 24 hrs*

RECORD

Cased 5 in. 3436 ft.Sand Arb 3436

Gas

Oil

Total Depth 3446

PRODUCTION

1st 24 hrs. Nat.

1st 24 hrs. after shot

Gas Cu. Ft.

Dry Hole

Abandoned

Date

OCT 5 - 1938

19

H. D. Hatfield Scout