


Map No. **KANSAS** Sec. **21** Twp. **30** R. **2E**

Well No. **1-Newton** Farm
Creutz & Stueck Company

NORTH **A. Wixson et al**

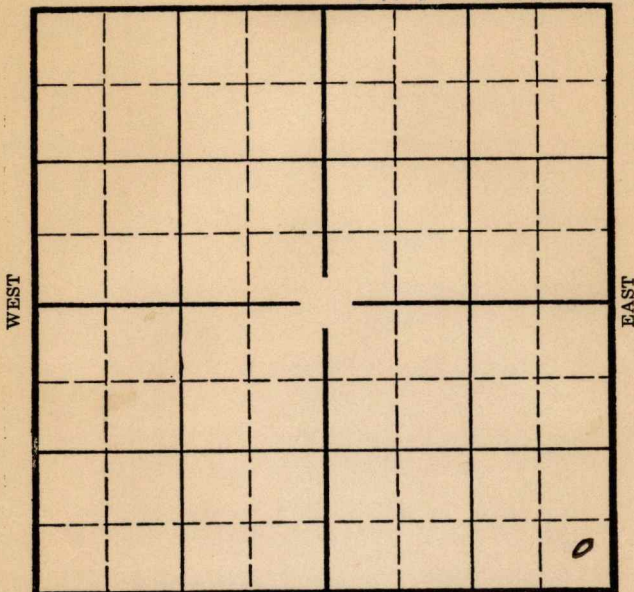

O. W. D. D

Location _____
Drilling Remarks _____

Rig Up _____
Drilling Remarks _____

RECORD

Cased _____ in. _____ ft.
Sand _____
Gas _____
Oil _____
Total Depth _____

PRODUCTION

1st 24 hrs. Nat. _____
1st 24 hrs. after shot _____
Gas _____ cu. ft. _____
Dry Hole _____
Abandoned _____

Summer

Map No. Sec. 21 Twp. 30 R. 2E

Well No. 1-Newton Farm


Orutt & Stuart
A. Wixson et al Company

 Ft. from N. Line

330 Ft. from S. Line

330 Ft. from E. Line

 Ft. from W. Line

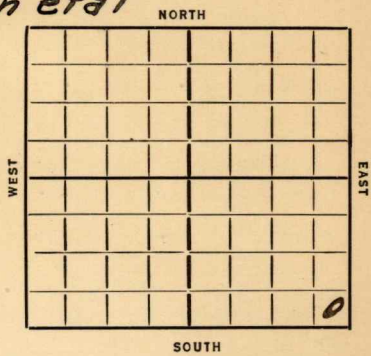

Date 1935

REPORT

O. W. D. D

10/24 R. W.
11/1
11/7 Spud
11/14 Spud & SD.
11/21 20" 50
11/29
12/6 SD.
12/13 12/19-
12/26 20" 75 Rep Rig
12/36 dly 200
1/10 SD 475
1/17
1/24 15" 460 SD 550
1/31 2/7-2/14-2/21-2/28-
3/13 --
3/20 --
3/27 -- 4/2--4/10--4/16--4/23--4/30--
5/7-- 5/14--5/21--5/28--6/4--6/11--
6/17/36-D & A - T.D. 550'.

**ABANDONED
OVER**

O. W. D. D

1936

12/2 Old T. D. 550'.
Drlg. 600'.

12/10 Drlg. 690'.

12/17 Drlg. 730'.

12/24 Drlg. 840'.

12/29 Drlg. 930'.

1937

1/7 Shut down 930'.

1/14 " " "

1/21 " " "

1/28 " " "

2/4 " " "

2/11 " " "

2/18 " " "

2/26 " " "

3/4 " " "

3/11 " " "

3/18 " " "

3/25 " " "

3/31 T. D. 930'.

ABANDONED

1937

O. W. D. D

9/1 Old T.D. 930'.
12" @ 1201'.

Shut down repairs.

9/10 Drlg. 1770'.

9/17 T.D. 1975'. Rng. 10".

9/24 Shut down.

10/2 " "

10/8 " "

OVER

1937

10/15 SD 1975'.

10/22 " "

10/29 " "

11/5 Drlg. 2530'.

11/12 K.C. 2575'. S.O. 2600'.
S.W. 2655-65'. Drlg. 2755'.

11/19 Drlg. 2975'.

11/26 " "

12/3 Chat 3140'. 6" @ 3206'.
Drlg. 3220' S.O.

12/10 6" @ 3259'. Drlg. 3305'.

12/17 Base Miss. 3483'.
Wilcox 3570'. Drlg. 3575'.
No shows.

12/22 Old T.D. 930'.
Sil. 3590'.
T.D. 3600'.

ABANDONED

Map No. 12 Sec. 21 Twp. 30 R. 2E

Well No. 1-Newton
Orcutt + Stuart Company

Contractor

FIRST REPORTS

SECTION PLAT

..... Ft. from N. Line
330 Ft. from S. Line
330 Ft. from E. Line
..... Ft. from W. Line

			e

Location.....

Rig up.....

Drilling and Remarks:

R 2

RECORD

Cased..... in., ft.
Sand.....
Gas.....
Oil.....
Total Depth.....

PRODUCTION

1st 24 hrs. Nat.....
1st 24 hrs. after shot.....
Gas..... Cu. Ft.
Dry Hole.....
Abandoned.....

Date

10-24-35 192.....

ORVAL MANNSCHRECK

Scout

Summer

Map No. 12 Sec. 21 Twp. 30 R. 25

Well No. Newton

Oscutt & Staudt Company

Contractor

SECTION PLAT

			0

_____ Ft. from N. Line

330 Ft. from S. Line

330 Ft. from E. Line

_____ Ft. from W. Line

ABANDONED

Location _____

Rig up _____

Drilling and Remarks:

DDA

RECORD

Cased _____ in., _____ ft.

Sand _____

Gas _____

Oil _____

Total Depth 550

PRODUCTION

1st 24 hrs. Nat. _____

1st 24 hrs. after shot _____

Gas _____ Cu. Ft.

Dry Hole _____

Abandoned _____

Date

JUN 17 1936 19 _____

S. J. LEWIS Scout

KANSAS

Map No. 12 Sec. 21 Twp. 30 R. 2E

Well No. Newton

Orcutt & Staudt Company

Contractor

SECTION PLAT

_____ Ft. from N. Line

330 Ft. from S. Line

330 Ft. from E. Line

_____ Ft. from W. Line

FIRST REPORT

OWTD

Location _____

Rig up _____

Drilling and Remarks:

Old TD 550

Dr 19600

RECORD

Cased _____ in., _____ ft.

Sand _____

Gas _____

Oil _____

Total Depth _____

PRODUCTION

1st 24 hrs. Nat. _____

1st 24 hrs. after shot _____

Gas _____ Cu. Ft.

Dry Hole _____

Abandoned _____

Date

DEC 2 1936

S. J. LEWIS Scout

KANSAS *Summer*

Map No. 12 Sec. 21 Twp. 30 R. 2E

Well No. 1 Newton

Orcutt & Staust Company

Contractor

SECTION PLAT

_____ Ft. from N. Line

330 Ft. from S. Line

330 Ft. from E. Line

_____ Ft. from W. Line

ABANDONED

Location _____

Rig up _____

Drilling and Remarks:

RECORD

Cased _____ in., _____ ft.

Sand _____

Gas _____

Oil _____

Total Depth 930

PRODUCTION

1st 24 hrs. Nat. _____

1st 24 hrs. after shot _____

Gas _____ Cu. Ft.

Dry Hole _____

Abandoned

Date

MAR 31 1937 19

S. J. LEWIS Scout

Summer

KANSAS

Map No. 12 Sec. 21 Twp. 30 R. 2E

Well No. 1 Newton

R. Wixson etal Company

Contractor

ABANDONED

SE/C

_____ Ft. from N. Line

330 Ft. from S. Line

330 Ft. from E. Line

_____ Ft. from W. Line

SECTION PLAT

			0

Location _____

Rig up _____

Drilling and Remarks:

OWDD OTD 930

DVA

RECORD

Cased _____ in., _____ ft.

Sand 511 3590

Gas _____

Oil _____

Total Depth 3600

PRODUCTION

1st 24 hrs. Nat. _____

1st 24 hrs. after shot _____

Gas _____ Cu. Ft.

Dry Hole _____

Abandoned _____

Date

DEC 22 1937 19

H. D. Hatfield Scout

