


Cowley

KANSAS

SECTION 2 TOWNSHIP 30S RANGE 3E

WELL NO. #1 Muller

COMPANY Shawver-Armour

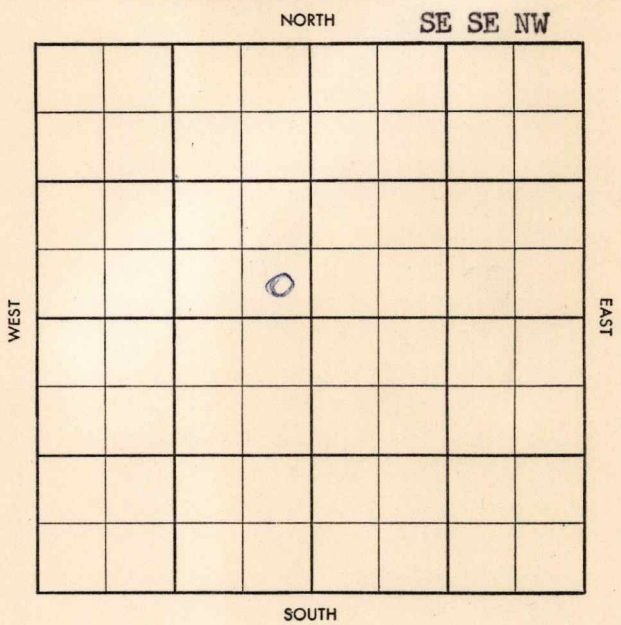

Twp. ~~Pool~~
~~Co.~~ ~~Facet~~

5-513-B

County Cowley Elev 12470 12478
 Sec. 2 Twp. 30 Rge. 3E
 Company Shawver - Armour
 Farm Name Muller No. 1

TOPS	DEPTH	LOG	DATUM
Anh.			
Tp.			
H.			
Tr. <u>sta</u>	<u>2168</u>	<u>2168</u>	
Dg.			
B.L.			
L.			
K.C.	<u>2505</u>	<u>2500</u>	
B.K.C.	<u>2760</u>	<u>2748</u>	
Ce. <u>Burgess</u>	<u>3066-74</u>		
C. <u>ee</u>		<u>2979</u>	
M.	<u>3169</u>	<u>3171</u>	
M. <u>case</u>		<u>3066-74 ?</u>	
K.			
Mz.			
Mq.			
V.			
S.			
S.			
A.			
R.			
Pf.			
G.			
T.D.	<u>3185</u>		

Loc. in Sec. SE SE NW
 Geol. _____
 Contr. _____
 Co. Tools MAPLE DISC
 Pool Wildcat
 COMPLETE
 JUL 23 '58

Date Comm. 5/26/58 Champion fo
8" @ 195 w/225, Drlg. 740. JUN 3 '58 Ø 3030
JUN 11 '58 DST 3057-73 1/2 hr 2800gip
60' 140cm 30 tail FP 25-40 BHP
1190/34 5" 3180 JUN 18 '58 CO 3108
24/ 3067-73 1/2 BOP G line 6x6
56d JUN 25 '58 JUL 2 '58 POP P 50 BOPD
NW est 38° gn P 75 B0 NW
22 hrs JUL 9 '58 P 25-30 BOPD NW
JUL 18 '58 JUL 23 '58 Phy P 58 BOPD + 170 w
gn 37°

Twp. ~~30~~ Pool. ~~3E~~
 Co. ~~3E~~ ~~3E~~
WILDCAT

S-513-B

County Cowley Elev. _____
 Sec. 2 Twp. 30 Rge. 3E
 Company Shawver - Armour
 Farm Name Muller No. 1

TOPS	DEPTH	LOG	DATUM
Anh.			
Tp.			
H.			
Tr.			
Dg.			
B.L.			
L.			
K.C.			
B.K.C.			
Ce.			
C.			
M.			
M.			
K.			
Mz.			
Mq.			
V.			
S.			
S.			
A.			
R.			
Pf.			
G.			
T.D.			

Loc. in Sec. _____
SE SE NW
 Geol. _____
 Contr. _____
Co. Tools
 Pool _____
Wildcat



Date Comm. 5/24/58
8" @ 195 w/225, Drlg. 740.

Co. _____
 Sec. _____
 T. _____
 R. _____