

KANSAS

FORM 51 5M 6-46 PETROL

Ellis county

Section 15 Township 13 Range 17-W

Well No. #1, L. Dreiling

Company Texas Company

NORTH

0							

SOUTH

WEST

EAST

13

KANSAS

Ellis ✓

Sec. 15 Twp. 13 R. 17W

Well No. #1 L. Dreiling Farm

Texas Company

Wildcat


Ft. from N. Line

330 Ft. from S. Line

Ft. from E. Line

330 Ft. from W. Line

SW/C

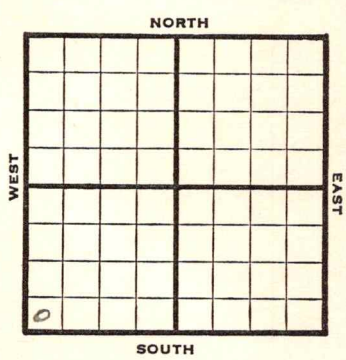

1946

Elev. 2002' REPORT

10/9 Location
10/15 RUR
10/22 Anhy 4235'
8" @ 1250'
Drlg 1935'
10/29 Drlg 3245'
11/6 Topeka 2900'
Lans 3332
Arb 3555'
5" @ 3560'
TD3583, SO
RUST
11/12 " "
11/20 TD 3583'
Swb 60 in 1½ hrs
Pump 559 Pot hold for gravity
11/27 Arb 3555'
5" @ 3560'
Pump 559 POT
TD 3583'
32 Grav.

COMPLETED

Map No. 71 Sec. 15 Twp. 13 R. 17WWell No. 1 L. DreilingTexas

Company

FIRST REPORT

Contractor

SW/C

SECTION PLAT

0			

Ft. from N. Line

330 Ft. from S. Line

Ft. from E. Line

330 Ft. from W. Line

Ellis County

Location X

Rig up

Drilling and Remarks:

RECORD

Cased _____ in., _____ ft.

Sand _____

Gas _____

Oil _____

Total Depth _____

PRODUCTION

1st 24 hrs. Nat. _____

1st 24 hrs. after shot _____

Gas _____ Cu. Ft.

Dry Hole _____

Abandoned _____

Date

OCT 9 1946 19 S. J. LEWIS Scout

Map No. 71 Sec. 15 Twp. 13 R. 17W

Well No. 1 L. Dreiling

Texas

Company

COMPLETED

Contractor

SW/C

E. 2002
SECTION PLAT

_____ Ft. from N. Line

330 Ft. from S. Line

_____ Ft. from E. Line

330 Ft. from W. Line

Ellis County

Location _____

Rig up _____

Drilling and Remarks:

As 43555

5" 23560

Pump 559 Bt.

02 2/2

RECORD

Cased _____ in., _____ ft.

Sand _____

Gas _____

Oil _____

Total Depth 2355

PRODUCTION

1st 24 hrs. Nat. _____

1st 24 hrs. after shot _____

Gas _____ Cu. Ft.

Dry Hole _____

Abandoned _____

Date

NOV 27 1946 19

S. J. LEWIS

Scout