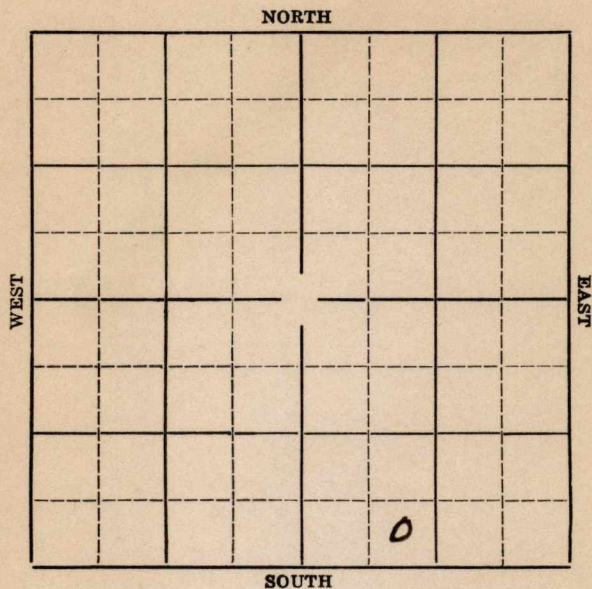


Section 3 Township 30 Range 3-EWell Number 1-DanielsCompany Wakefield et al

KANSAS

[illegible]

ABANDONED

KANSAS

Map No. 112 Sec. 3 Twp. 30 R. 34

Well No. 1 Tanie's

Wakfield et al Company

Contractor

SECTION PLAT

..... Ft. from N. Line

330 Ft. from S. Line

..... Ft. from E. Line

990 Ft. from W. Line

FIRST REPORT

Location.....

Rig up.....

Drilling and Remarks:

Spud.

RECORD

Cased.....in.,ft.

Sand.....

Gas.....

Oil.....

Total Depth.....

PRODUCTION

1st 24 hrs. Nat.....

1st 24 hrs. after shot.....

Gas.....Cu. Ft.

Dry Hole.....

Abandoned.....

Date

APR 22 1936

192.....

S. J. LEWIS

Scout

KANSAS

Map No. J 2 Sec. 3 Twp. 30 R. 34Well No. 1 DanielsWakefield & Co Company

Contractor

SECTION PLAT

_____ Ft. from N. Line

330 Ft. from S. Line

_____ Ft. from E. Line

990 Ft. from W. Line

ABANDONED

Location _____

Rig up _____

Drilling and Remarks:

sil 3/23 waterTH

RECORD

Cased _____ in., _____ ft.

Sand _____

Gas _____

Oil _____

Total Depth 3166

PRODUCTION

1st 24 hrs. Nat. _____

1st 24 hrs. after shot _____

Gas _____ Cu. Ft.

Dry Hole _____

Abandoned _____

Date

JUN 17 1936

S. J. LEWIS

Scout