


Map No. _____ Sec. 5 Twp. 30 R. 3 ^E
 Well No. 1 Hillebrecht Farm
Reynolds et al Company

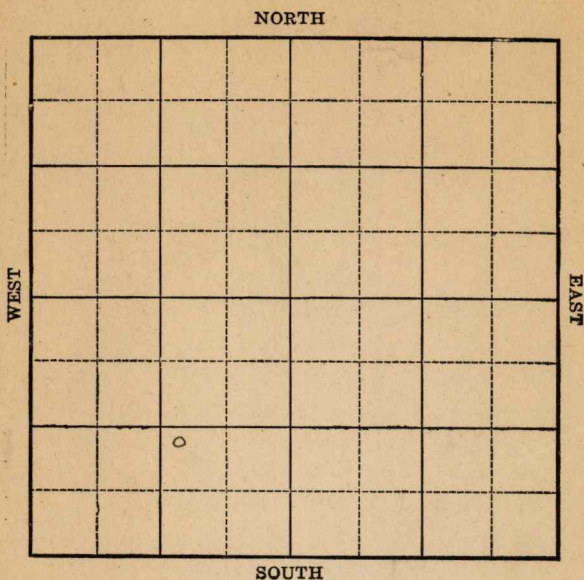

Location _____

Rig up _____

Drilling Remarks:

Drilling Remarks:

RECORD

Cased _____ in. _____ ft.

Sand _____

Gas _____

Oil _____

Total Depth _____

PRODUCTION

1st 24 hrs Nat. _____

1st 24 hrs. after shot _____

Gas _____ cu. ft.

Dry Hole _____


Abandoned _____

Map No. _____ Sec. 5 Twp. 30 R. 3EWell No. 1 Hillebrecht Farm
Reynolds Et al Company

_____ Ft. from N. Line

1120 Ft. from S. Line1120 Ft. from E. Line

_____ Ft. from W. Line

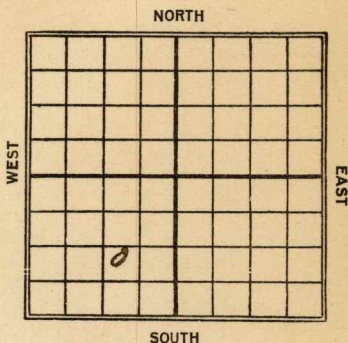

Date

REPORT

19233/30Location8/4Dlg 2450'11/3Top Line 2980'D & A 3395'

Map No. **KANSAS** 12 Sec. **5** Twp. **30** R. **3-E**

Well No. **1 Hillbrecht**

Reynolds et al Company

Contractor

FIRST REPORT

SECTION PLAT

_____ Ft. from N. Line

1120 _____ Ft. from S. Line

1120 _____ Ft. from E. Line

_____ Ft. from W. Line

	o		

Location **✓✓** _____

Rig up _____

Drilling and Remarks:

RECORD

Cased _____ in., _____ ft.

Sand _____

Gas _____

Oil _____

Total Depth _____

PRODUCTION

1st 24 hrs. Nat. _____

1st 24 hrs. after shot _____

Gas _____ Cu. Ft.

Dry Hole _____

Abandoned _____

Date

MAR 30 1923

192

M. A. BENEAR

Scout

Map No. **KANSAS** ¹² Sec. ⁵ Twp. ³⁰ R. ³Well No. ^{1 - Stillbush}
Reynolds et al Company

Contractor

ABANDONED SECTION PLAT

----- Ft. from N. Line

1120 Ft. from S. Line*1120* Ft. from E. Line

----- Ft. from W. Line

	0		

Location -----

Rig up -----

Drilling and Remarks:

Tap Line 2980
NO + A
3395'

RECORD

Cased ----- in., ----- ft.

Sand -----

Gas -----

Oil -----

Total Depth -----

PRODUCTION

1st 24 hrs. Nat. -----

1st 24 hrs. after shot -----

Gas ----- Cu. Ft.

Dry Hole -----

Abandoned -----

Date
NOV 3 1923**M. A. BENEAR**

----- 192-----

----- Scout

Butler

K12
MAP NO. **KANSAS** SEC. 5 TWP. 30S R. 3EWELL NO. 1 ParrotParbert & Reynolds COMPANY

CONTRACTOR

SECTION PLAT

ABANDONED

_____ FT. FROM N. LINE

_____ FT. FROM S. LINE

_____ FT. FROM E. LINE

_____ FT. FROM W. LINE

LOCATION _____

RIG UP _____

DRILLING AND REMARKS:

RECORD

CASED _____ IN. _____ FT.

SAND _____

GAS _____

OIL _____

TOTAL DEPTH 3390

PRODUCTION

1ST 24 HRS. NAT. _____

1ST 24 HRS. AFTER SHOT _____

GAS _____ CU. FT.

DRY HOLE ☒ABANDONED ☒**3395**

DATE

10/22/3

192

SCOUT