


KANSAS Barton County

FORM 51 5M PETROL

Section 21 - Township 17 Range 13W

Well No. 1 Soderstrom

Company Nadel & Gussman

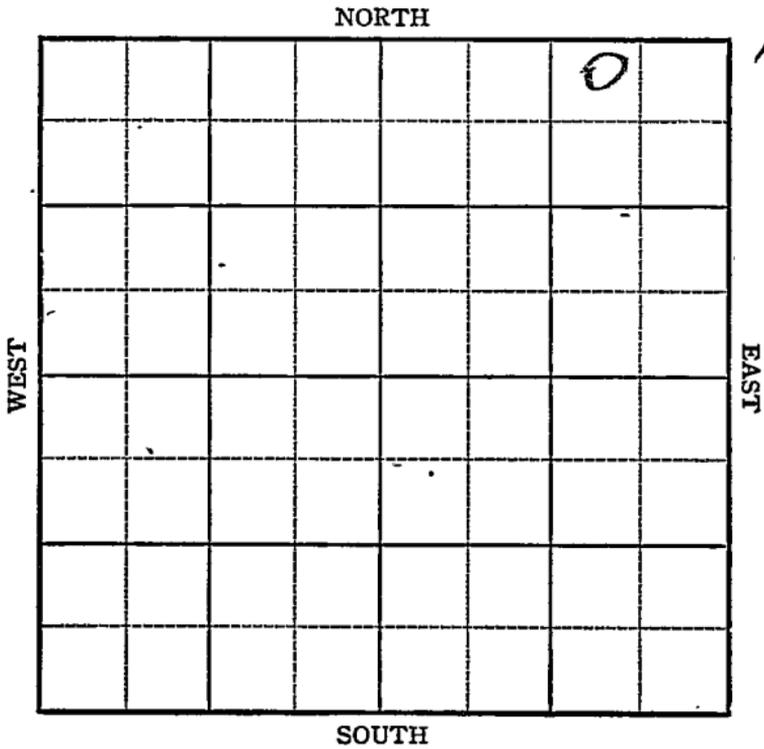

KANSAS

Barton

Sec. 21 Twp. 17 R. 13W


Well No. 1 Soderstrom Farm  
Nadel & Gussman Company

Carroll  
330 Ft. from N. Line

\_\_\_\_\_ Ft. from S. Line

990 Ft. from E. Line

\_\_\_\_\_ Ft. from W. Line

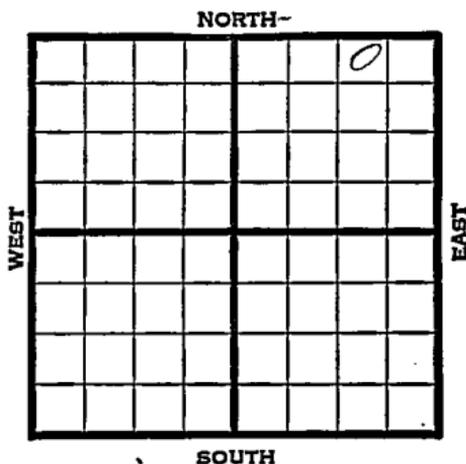

NW NE NE

1945

REPORT

Elev. 1961

6/6

RUR

6/14

8" @ 190

Drlg. 1485

6/21

Anhy 885

Lams 3227

Drlg. 3432

6/28

Arb 3441-44 TD

5" @ 3441 RUST

7/11

Arb. 3441

5" @ 3441

TD 3469' HFW

ABANDONED

Kansas Pool Name CarrollMap No. 73 Sec. 21 Twp. 17 R. 13WWell No. 1 SoderstromNadel & Gussman CompanyFIRST REPORT Contractor

NW NE NE

## SECTION PLAT

|  |  |  |   |
|--|--|--|---|
|  |  |  | 0 |
|  |  |  |   |
|  |  |  |   |
|  |  |  |   |

330 Ft. from N. Line

\_\_\_\_\_ Ft. from S. Line

990 Ft. from E. Line

\_\_\_\_\_ Ft. from W. Line

Barton County

Location \_\_\_\_\_

Rig up \_\_\_\_\_

Drilling and Remarks:

RUR

## RECORD

Cased \_\_\_\_\_ in., \_\_\_\_\_ ft.

Sand \_\_\_\_\_

Gas \_\_\_\_\_

Oil \_\_\_\_\_

Total Depth \_\_\_\_\_

PRODUCTION<sup>n</sup>

1st 24 hrs. Nat. \_\_\_\_\_

1st 24 hrs. after shot \_\_\_\_\_

Gas \_\_\_\_\_ Cu. Ft.

Dry Hole \_\_\_\_\_

Abandoned \_\_\_\_\_

Date

JUN 6 1945<sub>19</sub>S. J. LEWIS Scout

