


Section 15 Township 13 S Range 17 W

Well No. #2 Von Lintel

Company K & E Drlg. & Oil Trading

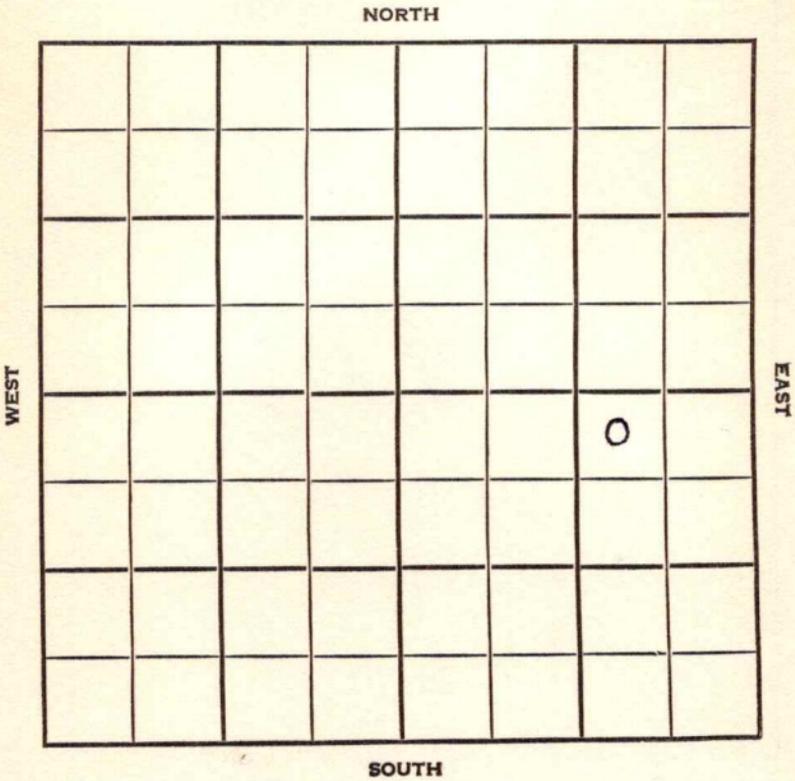

Ellis

KANSAS


SEC.	TWP.	R.
15	13S	17W

WELL NO. #2 Von Lintel FARM

COMPANY K & E Drlg & Oil Trading

CONTRACTOR Co Tools  
Karlin

\_\_\_\_\_ Ft. from N. Line  
 \_\_\_\_\_ Ft. from S. Line  
 \_\_\_\_\_ Ft. from E. Line  
 \_\_\_\_\_ Ft. from W. Line

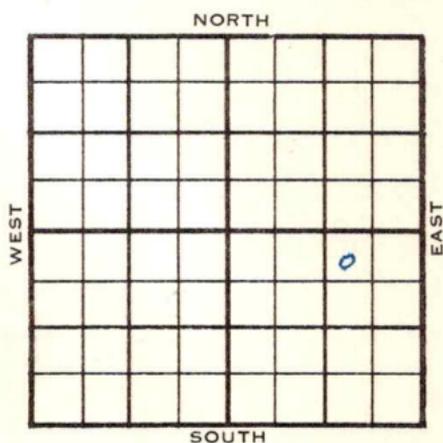

NW NE SE

1955 ELEVATION 1996 RB, 1993 DF REPORT

9/28 Comm 9-23-55  
 8" @ 144 w/135  
 Anh 1172  
 D 2575

11-23 DST 3300-45 op 1 hr. rec. 1980' GIP,  
 65' o&gcm, 290' vho&gcm, 70' oil,  
 560/20"  
 DST 3396-3436 op 1 hr. rec. 5' mud,  
 940/20"  
 DST 3500-07 op 1 hr. rec. 780' GIP  
 rec. 45' vho&gcm, 855' oil 700/20"  
 5 1/2" @ 3499  
 CO to 3507  
 S/ 9 1/4 bo 4 hr.  
 Comp. 50 bopd  
 H. 3198  
 L. 3244  
 A 3498  
 TD 3507'

COMPLETED

County **Ellis** Elev. **1996 RB**  
 Sec. **15** Twp. **13S** Rge. **17W**  
 Company **K & B Drlg & Oil Trading**  
 FarmName **Von Lintel** No. **2**

TOPS	DEPTH	LOG	DATUM	Loc. in Sec.																								
Anh.	<b>1172</b>			<b>NW NE SE</b>																								
Tr.																												
Dg.																												
Bl.																												
L.				Geol.																								
K.C.				Contr.																								
B.K.C.				<b>Co. tools</b>																								
Ce.				Pool																								
C.				<b>Karlin</b>																								
M.				<table border="1"> <tr><td></td><td></td><td></td></tr> <tr><td></td><td></td><td></td></tr> <tr><td></td><td></td><td></td></tr> <tr><td></td><td></td><td></td></tr> <tr><td></td><td></td><td></td></tr> <tr><td></td><td></td><td></td></tr> <tr><td></td><td></td><td></td></tr> <tr><td></td><td></td><td></td></tr> </table>																								
Mz.																												
Me.																												
V.																												
S.																												
A.																												
R.																												
PE.																												
G.																												
T.D.																												

FIRST REPORT

Date Comm. **9-23-55** SEP 28 1955  
**8" 1 1/4 w/135; D 2575**


Co.  
Lse.  
No.  
Sec.  
T.  
R.

County Ellis Elevation 1993 DF  
15 Sec. 13 Twp. 17W Range 1996 RB  
 Company K & E Drilg. & Oil Trading  
 Farm Name Von Lintel No. 2

TOPS	DEPTH	LOG	DATUM
Anh.	<u>1172</u>		
Tr.			
H.	<u>3198</u>		<u>1202</u>
Dg.			
B.L.			
L.	<u>3247</u>		<u>1248</u>
K.C.			
B.K.C.			
Ce.			
C.			
M.			
M.			
K.			
Mz.			
Me.			
V.			
S.			
S.			
A.	<u>3498</u>		<u>1502</u>
R.			
PE.			
G.			
T.D.	<u>3507</u>		

Loc. in Sec. NW NE SE  
 Geol. \_\_\_\_\_  
 Contr. \_\_\_\_\_  
 Co. tools \_\_\_\_\_  
 Pool Karlin



NOV 23 1955

Date Comm. 9-23-55

8" @ 144/135 DST 3300-45' open 1 hr.  
rec. 1980' GIP 65' o & gcm 290' who &  
gcm 70' oil 560/20" DST 3396-3436  
open 1 hr. rec. 5' mud 940/20"  
DST 3 500-07 open 1 hr. rec. 780' GIP  
rec 45' who & gcm 855' oil 700/20"  
5 1/2" @ 3499 CO to 3507 S/ 9 1/4 bo  
4 hr. Comp. 50 bopd

Co.  
 Lse.  
 No.  
 Sec.  
 T.  
 R.