


Ellis

KANSAS

SECTION 15 TOWNSHIP 13 RANGE 17W

WELL NO. #4 Von Lintel

COMPANY K & E Drlg.

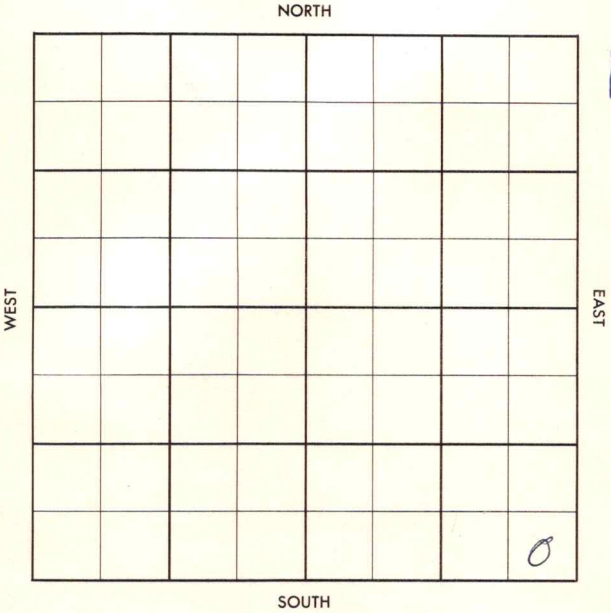

Ellis

KANSAS

SEC.	TWP.	R.
15	13	17W

WELL NO. #4 Von Lintel

COMPANY K & E Drlg

CONTRACTOR Co. Tools

Karlin


_____ FT. FROM N. LINE

_____ FT. FROM S. LINE

_____ FT. FROM E. LINE

_____ FT. FROM W. LINE

SE SE SE

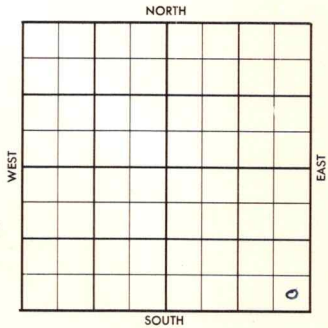

1956	ELEVATION	REPORT
------	-----------	--------

9-5 MIR

55555

FORM 513 SUNRAY

County Ellis Elev. _____
Sec. 15 Twp. 13 Rge. 17W
Company K & E Drlg.
Farm Name Von Lintel No. 4

TOPS	DEPTH	LOG	DATUM
------	-------	-----	-------

Anh.			
Tr.			
H.			
Tr.			
Dg.			
BL.			
L.			
K.C.			
B.K.C.			
Ce.			
C.			
M.			
M.			
K.			
Mz.			
Mq.			
V.			
S.			
S.			
A.			
R.			
Pe.			
G.			
T.D.			

Loc. in Sec. _____

SE SE SE

Geol. _____

Contr. _____

Co. tools

Pool

Karlin

SEP 15 '55		
FIRST REPORT		

Date Comm.

M I R

14

SEP 1 1955

W.M.

County EllisElev. 1992Sec. 15Twp. 13Rge. 17WCompany K & E Drlg.Farm Name Von LintelNo. 4

TOPS

DEPTH

LOG

DATUM

Loc. in Sec.

Anh.

1165

Tp.

SE SE SE

H.

3199

Tr.

Dg.

Bl.

L.

3243

K.C.

Geol.

B.K.C.

Contr.

Ce.

C.

Co. tools

M.

M.

K.

Pool

Mz.

Karlin

Mq.

V.

S.

S.

A.

3495

R.

Pe.

G.

COMPLETESEP 19 '56

I.D.

3498

Date Comm.

M I R SEP 2 '56 9-1-56 85/8165/125 DST 3246-54 1hr210' GIP, rec 240' 0 & 6 C SW+1200' SW BHP 800/30" 5 1/2@ 3497/575 SEP 19 '56 CO 3498 FU200' oil 1hr DD 3503 FU 2200'^{oil} Field 3 hrs Pop. P. 25 Bopdno/w to