

KANSAS

Barton

Section 21 Township 17 Range 13WWell No. 2 SoderstromCompany Ferrier et al

Hosington

NORTH

WEST

EAST

							0

SOUTH

KANSAS

Barton


 Sec. 21 Twp. 17 R. 13W

 Well No. #2 Soderstrom Farm
-Ferrier et al Company

Hosington Pool


330' Ft. from N. Line

 Ft. from S. Line

330' Ft. from E. Line

 Ft. from W. Line

NE/C

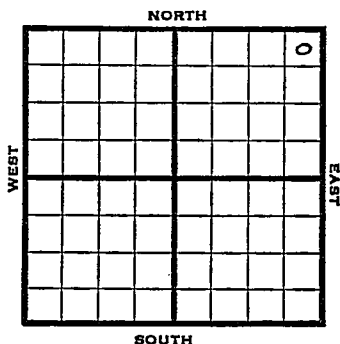

1948 Elev. 1953' REPORT

3/10	Location
3/17	"
3/24	"
3/31	"
4/7	8" @ 287' Drlg. 1750'
4/14	Lansing 3199' Drlg. 3320'
4/21	Arbuckle 3430' 5" @ 3430'-3432' 500 Acid swb 4 bbls oil PH, 8 hrs.
4/28	Arbuckle 3430' 5" @ 3430' 500 Acid Pump 100 Oil Pot. Gr. 36° TD 3436'

COMPLETED

Map No. _____ Sec. 21 Twp. 17 R. 13W

Well No. 2 Soderstrom

Ferrier etal. Company

FIRST REPORT

Contractor

NE/C


SECTION PLAT

330 Ft. from N. Line

_____ Ft. from S. Line

330 Ft. from E. Line

_____ Ft. from W. Line

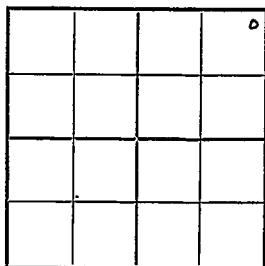

Barton County

Location X

Rig up _____

Drilling and Remarks:

RECORD

Cased _____ in., _____ ft.

Sand _____

Gas _____

Oil _____

Total Depth _____

PRODUCTION

1st 24 hrs. Nat. _____

1st 24 hrs. after shot _____

Gas _____ Cu. Ft.

Dry Hole _____

Abandoned _____

Date

MAR 10 1948 19 S. J. LEWIS Scout

Map No. 73 Sec. 21 Twp. 17 R. 13W

Well No. 2 Soderstrom

Ferrier & Co. Company

COMPLETE

Contractor

NE/C

E. J. 1953

SECTION PLAT

330 Ft. from N. Line

Ft. from S. Line

330 Ft. from E. Line

Ft. from W. Line

			4

Barton County

Location _____

Rig up _____

Drilling and Remarks:

288430

5" 28430

500 Seal

Run 100 ril 28

28624

RECORD

Cased _____ in., _____ ft.

Sand _____

Gas _____

Oil ☒

Total Depth 2426

PRODUCTION

1st 24 hrs. Nat. _____

1st 24 hrs. after shot _____

Gas _____ Cu. Ft.

Dry Holes _____

Abandoned _____

Date

APR 28 1948

S. J. LEWIS

Scout