


Ellis

KANSAS

SECTION 15 TOWNSHIP 13 RANGE 17W

WELL NO. #5 Von Lintel

COMPANY K & E & Oil Trading

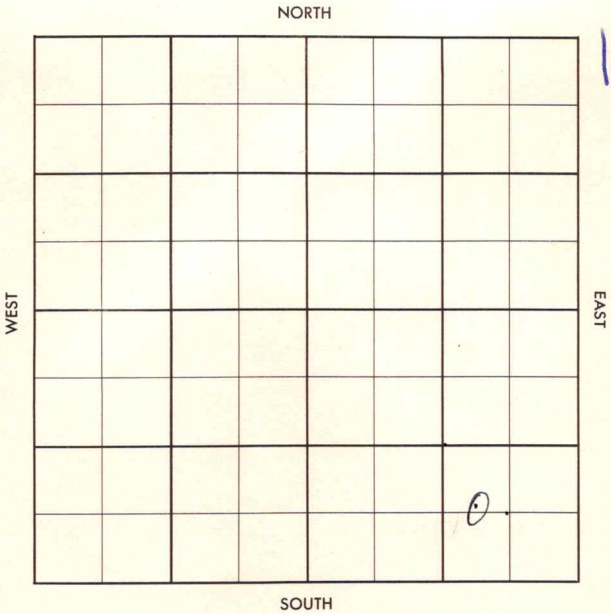

E1718

Elev.

Sec.

15

Twp.

21

Res.

17W

Company

K & E & Oil Trading

Farm Name

Von Lintel

No.

5

FIRST REPORT

DEC 12 '56

Date Comm.

M I R

Co.

Use:

No.

Sec.

7.

五

County Ellis Elev. 1994
 Sec. 15 Twp. 13 Rge. 17W
 Company K & E & Oil Trading
 Farm Name Von Lintel No. 5

TOPS	DEPTH	LOG	DATUM	Loc. in Sec.
Anh.				C W $\frac{1}{2}$ SE SE
Tp.				
H.	3201			
Tr.	3220			
Dg.				Geol.
Bl.				
L.	3246			
K.C.				
B.K.C.				Contr.
Ce.				
C.				
M.				
M.				Pool
K.				
Mz.				
Ma.				
V.				COMPLETE
S.				
S.				
A.	3497			
R.				JAN 23 '57
Pe.				
G.				
T.D.	3602			

Date Comm.

M I R DEC 19 '56 12-11-56 858 163

1125 ϕ 3191 DEC 26 '56 R119 5 1/2

JAN 2 '57 DST 3274-80 1hr 155'

MW BHP 440/20" DST 3294

-3354 90" 1800' GIP res

840' oil + 120' VHO CM BHP

790 DST 3374-3440 45"

res 30' Md BHP 610/20"

DST 3525-40 or 1hr res 120'

GIR + 720' HOCW + 780' SOCW
 BHP 840/20" DST 3540-60
 30" per 310' VHO & GCM
 +60' Free oil BHP 1000/20"
 5 1/2 @ 3602/135 MICT 66/
 3544-55 no test 1/2 \$ rate
 45 Boph no/w 2 hrs POP
 JAN 9 '57 P. 25 Bopd no/w
 JAN 16 '57 JAN 23 '57 P. 25 Bopd
 no/wt.