

Map No.----- Sec. 10 Twp. 30 R. 3

Well No. 1 Carlton Farm
Elmer et al Company

Elmer et al Company

NORTH

WEST

EAST

COMPLETED

SOUTH

Location_____

Drilling Remarks:

Rig Up-----

Drilling Remarks:

RECORD

Cased----- in.----- ft.

Sand -----

Gas: -----

Oil _____

Total Depth_____

PRODUCTION

1st 24 hrs. Nat.-----

1st 24 hrs. after shot-----

Gas_____cu. ft


Dry Hole-----

Abandoned -----

Map No. Zone Sec. 10 Twp. 33 R. 3EWell No. 1 Carlton Farm
E. Wells et al Company

NORTH

WEST

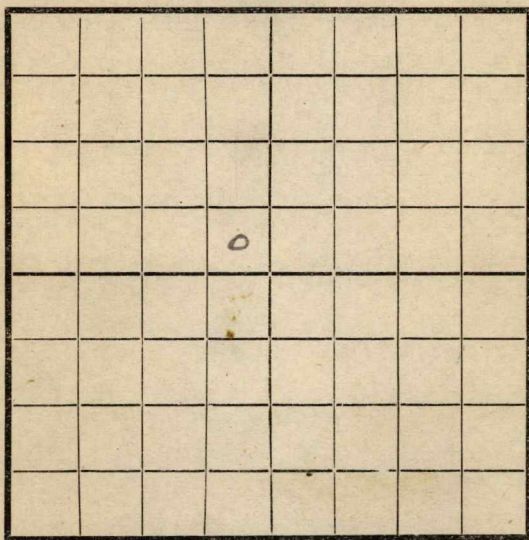

EAST

SOUTH

Location -----

Rig Up -----

Drilling and remarks

Timber

RECORD

Cased ----- in. ----- Ft.

Sand -----

Gas -----

Oil -----

Total Depth -----

PRODUCTION

1st 24 hrs. Nat. -----

1st 24 hrs. after shot -----

Gas ----- Cu. Ft.

Dry Hole -----

Abandoned -----

Date

First Report
Dec 3, 1918 C. Conley

Scout

Map No. Howe Sec. 10 Twp. 30 R. 3Well No. Carlton FarmChivell et al Company

NORTH

WEST

EAST

SOUTH

RECORD

Location ✓Rig Up ✓

Drilling and remarks

This I reported
abandoned. but
they have made
other arrangements
and a test will
be drilled here

Cased _____ in. _____ Ft.

Sand _____

Gas _____

Oil _____

Total Depth _____

PRODUCTION

1st 24 hrs. Nat. _____

1st 24 hrs. after shot _____

Gas _____ Cu. Ft.

Dry Hole _____

Abandoned _____

Date

3/9, 1918 Condy Scout


Map No. _____ Sec. 10 Twp. 30 R. 3

Well No. Carlton Farm _____

Chancellor et al Company _____

NORTH

WEST

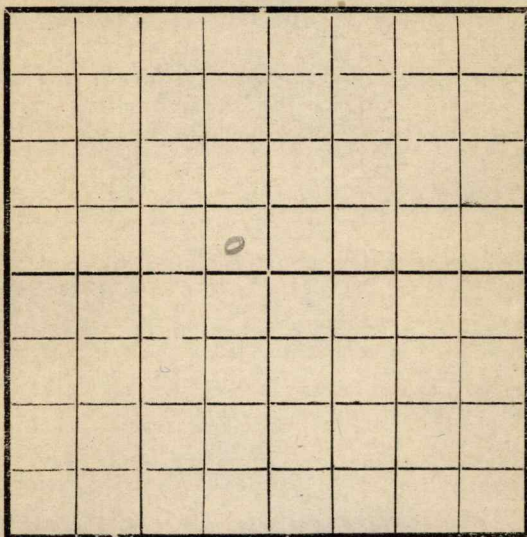

EAST

SOUTH

RECORD

Location _____

Cased _____ in. _____ Ft.

Rig Up _____

Sand _____

Drilling and remarks

Gas _____

Oil _____

Total Depth _____

2030

PRODUCTION

1st 24 hrs. Nat. _____

1st 24 hrs. after shot _____

Gas _____ Cu. Ft.

Dry Hole _____

Abandoned _____

Date

5/15, 1911 J. C. Cady Scout

Map No. _____ Sec. 10 Twp. 30 R. 3
Well No. 1 Coulton
E. L. Well Oil Company
Contractor _____

NORTH

WEST

EAST

SOUTH

Location _____

Rig up.....

Drilling and Remarks:

2606

RECORD

Cased-----in., -----ft.

Sand_____

Gas _____

Oil _____

Total Depth_____

PRODUCTION

1st 24 hrs. Nat. _____

1st 24 hrs. after shot.....

Gas.....Cu. Ft.

Dry Hole.....


Abandoned.....

Date _____

Date 6/4 191 P. Cordiff Scout

Map No. _____ Sec. 10 Twp. 30 R. 3Well No. 1 CarltonE. L. Well et al Company

Contractor _____

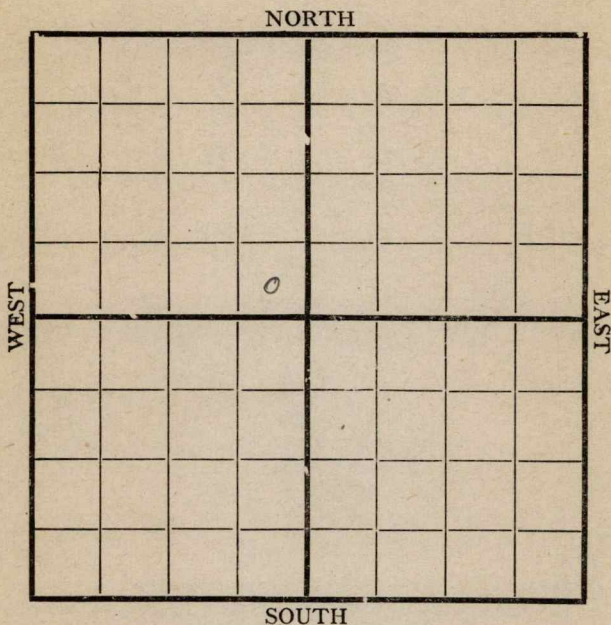

Location _____

Rig up _____

Drilling and Remarks:

2665**RECORD**

Cased _____ in., _____ ft.

Sand _____

Gas _____

Oil _____

Total Depth _____

PRODUCTION

1st 24 hrs. Nat. _____

1st 24 hrs. after shot _____

Gas _____ Cu. Ft.

Dry Hole _____

Abandoned _____

Date

6/21

191

J. C. Carney

Scout

Map No. _____ Sec. 10 Twp. 30 R. 3

Well No. 1 Carlton
Cleveland O & G Company

Company

Contractor

NORTH

WEST

EAST

SOUTH

Location _____

Rig up.....

Drilling and Remarks:

28/2

RECORD

Cased _____ in., _____ ft.

Sand

Gas -----

Oil _____

Total Depth.....

PRODUCTION

1st 24 hrs. Nat. -----

1st 24 hrs. after shot-----

Gas.....Cu. Ft.

Dry Hole._____

Abandoned.....

Date _____

6/26

191

J. C. Casley

Scout

Map No. _____ Sec. 10 Twp. 30 R. 3
Well No. 1 Carlton
Ervell 275 _____ Company
_____ Contractor

NORTH

WEST

EAST

SOUTH

Location _____

Rig up.....

Drilling and Remarks:

RECORD

Cased _____ in., _____ ft.

Sand_____

Gas _____

Oil

Total Depth_____

PRODUCTION

1st 24 hrs. Nat. -----

1st 24 hrs. after shot -----

Gas.....Cu. Ft.

Dry Hole.....


Abandoned.....

Date _____

Date 7/3 J. C. Caudy Scout

Map No. _____ Sec. 10 Twp. 30 R. 3Well No. 1 Carlton
Elwell & S Company

Contractor _____

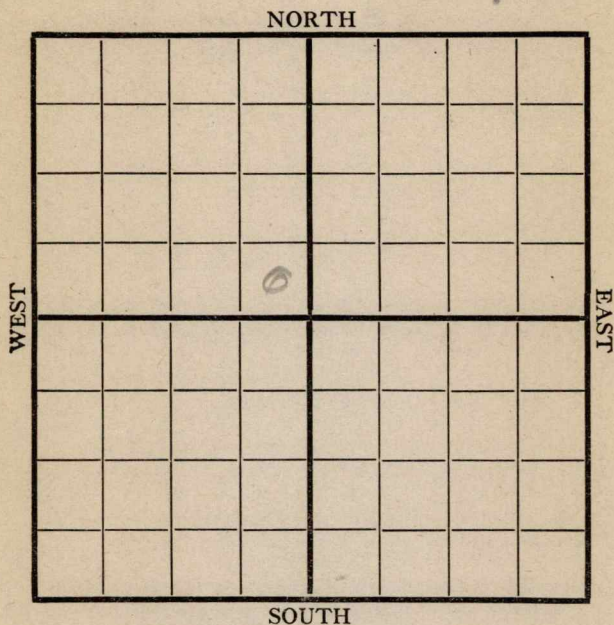

Location _____

Rig up _____

Drilling and Remarks:

2945-**RECORD**

Cased _____ in., _____ ft.

Sand _____

Gas _____

Oil _____

Total Depth _____

PRODUCTION

1st 24 hrs. Nat. _____

1st 24 hrs. after shot _____

Gas _____ Cu. Ft.

Dry Hole _____

Abandoned _____

Date

7/12 191 8 Carlton Scout

Map No. _____ Sec. 10 Twp. 30 R. 3
 Well No. 1 Carlton
2nd well stop Company _____ Contractor _____

NORTH							
WEST							
SOUTH							

Location _____

Rig up _____

Drilling and Remarks:

*Hole full
 water
 2945*

RECORD

Cased _____ in., _____ ft.

Sand _____

Gas _____

Oil _____

Total Depth _____

PRODUCTION

1st 24 hrs. Nat. _____

1st 24 hrs. after shot _____

Gas _____ Cu. Ft.


Dry Hole _____

Abandoned _____

Date

7/17 J. C. Cardiff

Map No. K12 Sec. 10 Twp. 30 R. 3
 Well No. 1 Carlton
E & Well 08-5 Company
Birmingham Drill Co Contractor
Augusta NORTH Ks.

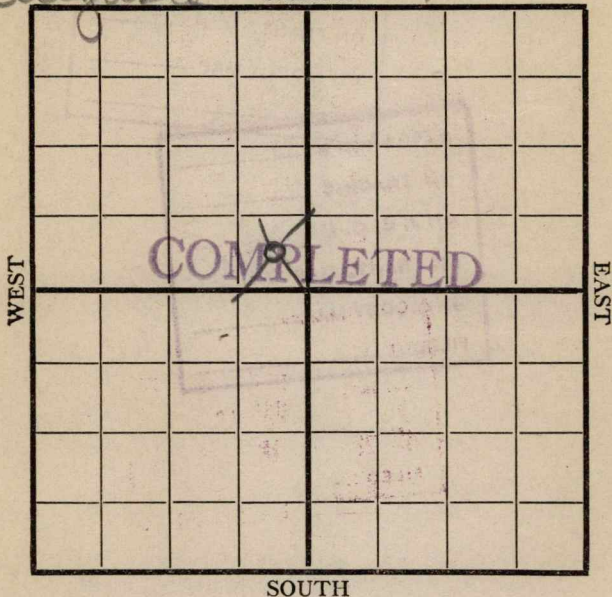

Location _____

Rig up _____

Drilling and Remarks:

*Dry and
abandoned
2975*

RECORD

Cased _____ in., _____ ft.

Sand _____

Gas _____

Oil _____

Total Depth _____

PRODUCTION

1st 24 hrs. Nat. _____

1st 24 hrs. after shot _____

Gas _____ Cu. Ft.

Dry Hole _____

Abandoned _____

Date

7/22 1918 C. C. C. Co. Scout

Butler
 K12
 MAP NO. **KANSAS** SEC. 10 TWP. 30S R. 3E
 WELL NO. 1 Carlton
Elwell et al COMPANY

CONTRACTOR

SECTION PLAT

ABANDONED

_____ FT. FROM N. LINE
 _____ FT. FROM S. LINE
 _____ FT. FROM E. LINE
 _____ FT. FROM W. LINE

	0		

LOCATION _____

RIG UP _____

DRILLING AND REMARKS:

OK.

RECORD

CASED _____ IN. _____ FT.
 SAND _____
 GAS _____
 OIL _____
 TOTAL DEPTH 2976

PRODUCTION

1ST 24 HRS. NAT. _____
 1ST 24 HRS. AFTER SHOT _____
 GAS _____ Cu. Ft.
 DRY HOLE ☒
 ABANDONED ☒

DATE

7/23 1928 _____ SCOUT