


Section 21 Township 17 Range 13W

Well No. #6 Soderstrom

Company Aladdin Pet.

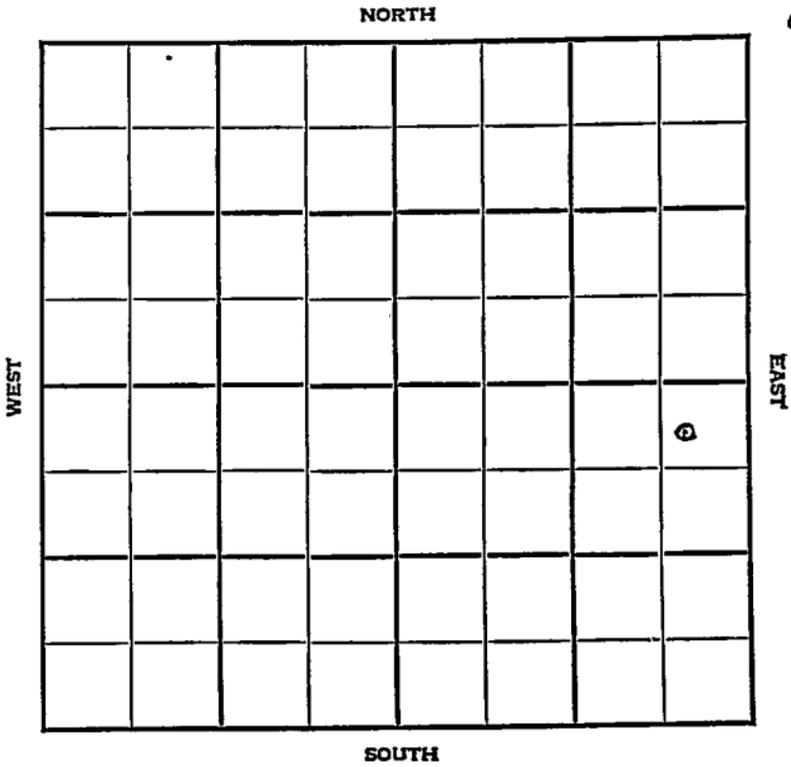



Sec. 21 Twp. 17 R. 13W

Well No. #6 Soderstrom Farm

Aladdin Pet. Company

Hoisington


330 Ft. from N. Line

_____ Ft. from S. Line

405 Ft. from E. Line

_____ Ft. from W. Line

NE SE

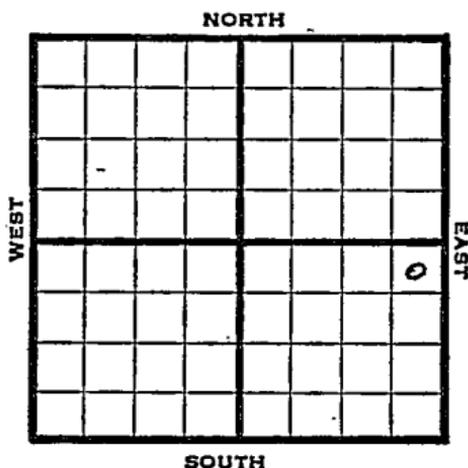

1948

Elev. 1986' REPORT

1/28 Twin well 75' west of #2
RUR

2/4 8" @ 310'
Anhydrite 840'
Drlg. 1955'

2/11 Lansing 3176'
Arbuckle 3399'
TD 3403'
4" @ 3402'
RUST

2/18 "

2/25 TD 3417'
1200' oil 1 1/2 hrs.

3/3 "

3/10 TD 3419'

3/17 Arb. 3399'
4" @ 3402'
Pump 100 Pot.
Gr. 37°
TD 3419'

COMPLETED

Map No. _____ Sec. 21 Twp. 17 R. 13W

Well No. 6 Soderstrom

Aladdin Pet. Company

FIRST REPORT

Contractor

NE SE

SECTION PLAT

330 Ft. from N. Line

_____ Ft. from S. Line

405 Ft. from E. Line

_____ Ft. from W. Line

| | | | |
|--|--|--|---|
| | | | |
| | | | |
| | | | o |
| | | | |

Barton County

Location _____

Rig up _____

Drilling and Remarks:

twin well

75' west of #2

R U R

RECORD

Cased _____ in., _____ ft.

Sand _____

Gas _____

Oil _____

Total Depth _____

PRODUCTION

1st 24 hrs. Nat. _____

1st 24 hrs. after shot _____

Gas _____ Cu. Ft.

Dry Hole _____

Abandoned _____

Date

JAN 28 1948 19

S. J. LEWIS Scout

Map No. 73 Sec. 21 Twp. 17 R. 13W

Well No. 6 Soderstrom

Aladdin Pet. Company

COMPLETE Contractor

NE SE

E. 1986
SECTION PLAT

330 Ft. from N. Line

_____ Ft. from S. Line

465 Ft. from E. Line

_____ Ft. from W. Line

| | | | |
|--|--|--|---|
| | | | |
| | | | |
| | | | 4 |
| | | | |

Barton County

Location _____

Rig up _____

Drilling and Remarks:

Q 83377
4" 8402
Pump 100
87-88

RECORD

Cased _____ in., _____ ft.

Sand _____

Gas _____

Oil

Total Depth 847

PRODUCTION

1st 24 hrs. Nat. _____

1st 24 hrs. after shot _____

Gas _____ Cu. Ft.

Dry Hole _____

Abandoned _____

Date

MAR 17 1948 19 S. J. LEWIS Scout