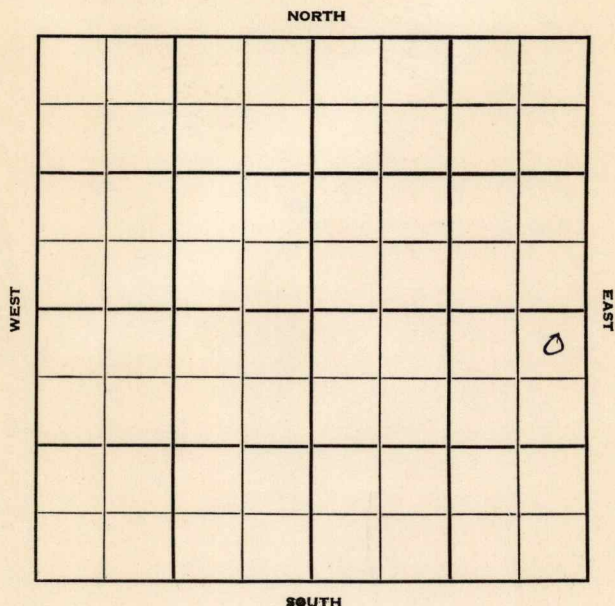


Section 10 Township 30 Range 3EWell No. #1 Jay JOY (KGS-DNL)Company Ed Adair

Cowley

KANSAS

Sec. 10 Twp. 30 R. 3E

Well No. #1 Jay JOY (UGS-ONL) Farm

Ed Adair

Company

Contractor

330'

Ft. from N. Line


Ft. from S. Line

330'

Ft. from E. Line

Ft. from W. Line

NE NE SE

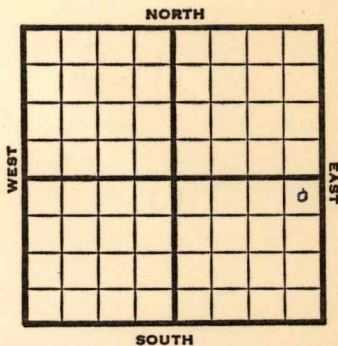

1951

Elev. 1181'

REPORT

6/13

RUR

6/27

Spud 6-15-51 D & A TD 2372'
8" @ 78 Stal. 2098' TD 2372'
D & A

ABANDONED

County Cowley State Kansas

Sec. 10 (Blk. Twp.) 30 (Sur. Rge) 3E Map No.

Operator Ed Adair

Well No. 1 Farm Joy

Elev.	1181	Location	NE NE SE
-------	------	----------	----------

330 Ft. From N Line SE

330 Ft. From E Line Quarter

1st. Report

Completion JUN 27 1951

Remarks


Spudding Date 6-15-51

Drlg. Data D & A TD 2372

8" @ 78 Stal. 2098 TD 2372

D & A

J. E. TYRA

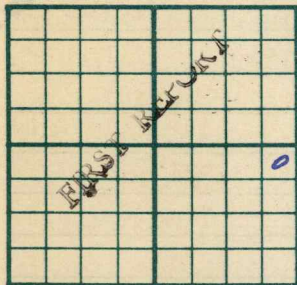County **Cowley** State **Kansas**Sec. **10** (Blk. Twp.) **30** (Sur. Rge.) **3E** Map No.Operator **Ed Adair**Well No. **1** Farm **Jay JOY (1665/DNL)**Elev. Location **NE NE SE****330** Ft. From **N** Line **SE****330** Ft. From **E** Line QuarterIst. Report **JUN 13 1951**

Completion

Remarks

Spudding Date

Drlg. Data

RUR**J. E. TYRA**