

Section 21 Township 17 Range 13WWell No. #5 SoderstromCompany Aladdin Pet

Hosington

NORTH

16

WEST

EAST

							0

SOUTH

KANSAS

Barton

Sec. 21 Twp. 17 R. 13W

Well No. #5 Soderstrom Farm

Aladdin Pet. Company

Hosington Pool

 Ft. from N. Line

330'


 Ft. from S. Line

330'

 Ft. from E. Line

 Ft. from W. Line

SE/C

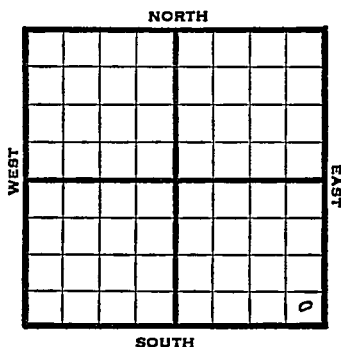

1948

Elev. 1924' REPORT

1/7 Location

1/14 RUR

1/21 8" @ 303'

Drlg. 2473'

1/26 Lansing 3180'

Arbuckle 3402-09'

TD 3409'

5" @ 3404'

RUST

2/4 "

2/11 Arb. 3396'

5" @ 3398'

Pump 100 Pot.

Gr. 36.0

TD 3403'

Comp.

COMPLETED

Map No. _____ Sec. 21 Twp. 17 R. 13W

Well No. 5 Soderstrom

Aladdin Pet. Company

FIRST REPORT

SE/C Contractor


SECTION PLAT

_____ Ft. from N. Line

330 Ft. from S. Line

330 Ft. from E. Line

_____ Ft. from W. Line

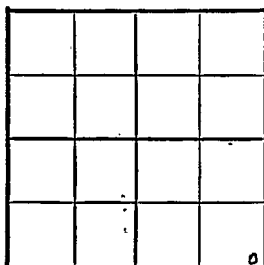

Barton County

Location X

Rig up _____

Drilling and Remarks:

RECORD

Cased _____ in., _____ ft.

Sand _____

Gas _____

Oil _____

Total Depth _____

PRODUCTION

1st 24 hrs. Nat. _____

1st 24 hrs. after shot _____

Gas _____ Cu. Ft.

Dry Hole _____

Abandoned _____

Date

JAN 7 1948 19

S. J. LEWIS Scout

Kansas

Map No. 73 Sec. 21 Twp. 17 R. 13WWell No. 5 SoderstromAladdin Pet.

Company


COMPLETE

Contractor

SE/C

E. I. 1924

SECTION FLAT

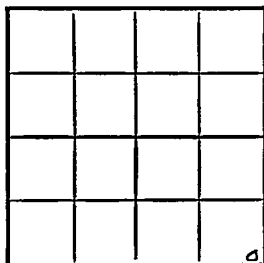 Ft. from N. Line330 Ft. from S. Line330 Ft. from E. Line Ft. from W. LineBarton CountyLocation Rig up

Drilling and Remarks:

Ar 438965103398Prop 100 BX26-2

RECORD

Cased in., ft.Sand Gas Oil Total Depth 8403

PRODUCTION

1st 24 hrs. Nat. 1st 24 hrs. after shot Gas Cu. Ft.Dry Hole Abandoned

Date

2-11-48REBDEC 23 1947

19

S. J. LEWIS

Scout