


Map No. **KANSAS** Sec. **13** Twp. **30** R. **Cowley 3E**
 Well No. **1- Bush** Farm _____
Baden Company _____

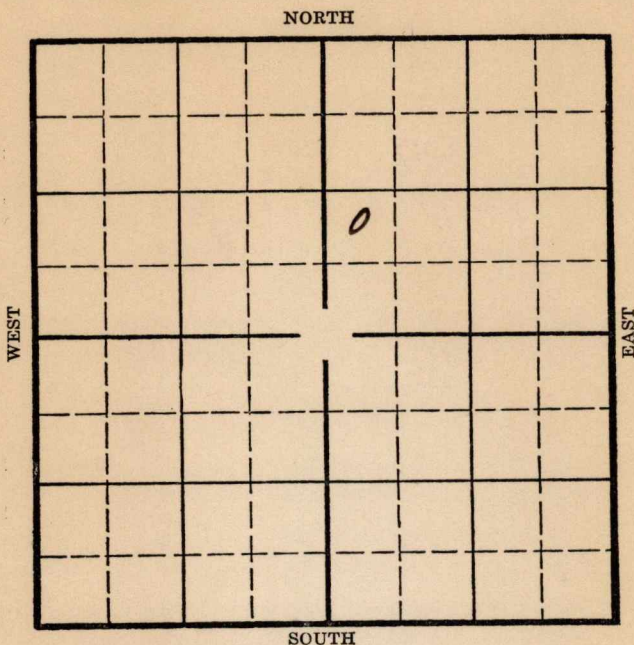

Location _____
 Drilling Remarks _____

Rig Up _____
 Drilling Remarks _____

RECORD

Cased _____ in. _____ ft.
 Sand _____
 Gas _____
 Oil _____
 Total Depth _____


PRODUCTION

1st 24 hrs. Nat. _____
 1st 24 hrs. after shot _____
 Gas _____ cu. ft. _____
 Dry Hole _____
 Abandoned _____

Cowley

Map No. **KANSAS** Sec. *13* Twp. *30* R. *3E*
Well No. *1- Bush* Farm
Baden Company

_____ Ft. from N. Line
990 Ft. from S. Line
_____ Ft. from E. Line
330 Ft. from W. Line

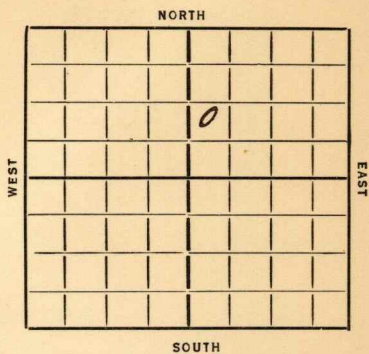

REPORT

Date *1935*
12/18 *Allen*
12/26 *1/2/36 - 1/10 - 1/17 -*
1/22 *Loc. abd.*

ABANDONED

KANSAS

Map No. 12 Sec. 13 Twp. 30 R. 3EWell No. 1-BushBaden

Company

Contractor

FIRST REPORTS

SECTION PLAT

		0	

Ft. from N. Line

990 Ft. from S. Line

Ft. from E. Line

330 Ft. from W. Line

Location

Rig up

Drilling and Remarks:

cellar

RECORD

Cased in., ft.

Sand

Gas

Oil

Total Depth

PRODUCTION

1st 24 hrs. Nat.

1st 24 hrs. after shot

Gas Cu. Ft.

Dry Hole

Abandoned

Date

ORVAL MANN SCHRECK

12-18-35 192

Scout

KANSAS

Map No. 12 Sec. 12 Twp. 30 R. 3 E

Well No. 1 - Bush

Bader Company

Contractor

SECTION PLAT

		0	

Ft. from N. Line

990 Ft. from S. Line

Ft. from E. Line

330 Ft. from W. Line

COMPLETED

Location

Rig up

Drilling and Remarks:

Loc.

Ahd.

RECORD

Cased in., ft.

Sand

Gas

Oil

Total Depth

PRODUCTION

1st 24 hrs. Nat.

1st 24 hrs. after shot

Gas Cu. Ft.

Dry Hole

Abandoned

Date

JAN 22 1936

192

Scout

C. V. + 1 MANNSCHRECK